

**SURVEY &  
REMONUMENTATION**

APR 28 1995

COMMISSION

Filed under Remonumentation Act 345 of 1990

LAND CORNER RECORDATION CERTIFICATE

Filing Requirement of Act 74, Mich. P.A. 1970

LIBER 001 PAGE 38

**FILED**

DEC 05 1994 2:01 P.

LENAWEE COUNTY  
JEANETTE D. INOX  
REGISTER OF DEEDS

Register of Deeds Stamp & File Number

For corners in

Lenawee  
(County)

Located In:

Corner Code #

- |                                    |  |            |
|------------------------------------|--|------------|
| 1. Public Land Survey              | T <u>7</u> - S <u>4</u> R - <u>4</u> - E | <u>G-4</u> |
|                                    | T _____ R _____                          | _____      |
|                                    | T _____ R _____                          | _____      |
|                                    | T _____ R _____                          | _____      |
| 2. Property Controlling in Section | S _____ T _____ R _____                  | _____      |
|                                    | S _____ T _____ R _____                  | _____      |
| 3. Miscellaneous Property in Sec.  | S _____ T _____ R _____                  | _____      |
|                                    | S _____ T _____ R _____                  | _____      |

4. Lot No. \_\_\_\_\_, Recorded Plat \_\_\_\_\_  
5. Private Claims \_\_\_\_\_

	A	B	C	D	E	F	G	H	I	J	K	L	M
1													
2	6	5	4	3	2	1							
3													
4	7	8	9	10	11	12							
5													
6	18	17	16	15	14	13							
7													
8	19	20	21	22	23	24							
9													
10	30	29	28	27	26	25							
11													
12	31	32	33	34	35	36							
13													

I, Glenn E. Richard, in a field survey on November 7 1994, do hereby certify that under requirements of P.A. 74, Michigan P.A. of 1970, the corner points mentioned in lines 1 and 2 above were in conformance with regulations and rules therefore as required in the current manual of survey instructions of the United States Department of the Interior, Bureau of Land Management or by a decree of a Court of Law and/or that the corner points mentioned in lines 3, 4 and 5 above were in conformance with the rules of the Michigan Board of Land Surveyors or by a Decree of a Court of Law; established, re-established, monumented, re-monumented, recovered, found as expressed below:

**NOTE: Not more than 4 corners, all in the same town and range, may be recorded on this certificate.**

**A. Description of original monument and accessories and/or subsequent restoration:**


G.L.O. July 1819, Joseph Fletcher set 1/4 post, Hickory 9 S 82 E 13, W. Ash 16 S 12 E 20 April 1882, James Blair found large stone 32 links north of RR. & 22 links West of RR. November 1924, Walter Frazier, R.L.S. 2268, Found stone 21.1 North of N. rail. November 7, 1969, I set a 1/2" X 3' iron pipe 32 links (21.12') North of the north rail and on a line south from Blair's corners at the West 1/4 corner (strap iron) and the 1/8 corner (large sq. hd. bolt). I measured 0.80 more than Blair in the N. 1/2 and 0.89 more in the S. 1/2 of the west line of the NW. 1/4 of Sec. 10. Blair measured 89° 01' between the Cen., W. 1/4 Cor. and SW. Cor. of Sec. 10 and in October 1986 we measured 89° 00' 05". May 1980, K.L. Suydam, P.S. 17636, found the Iron pipe and recorded it in L. 4, P. 376.

**B. Description of corner evidence found and/or method applied in restoring or reestablishing corner:**

September 21, 1994, Found iron pipe which checked the only two remaining witnesses of mine and three remaining witness of K.L. Suydam. November 7, 1994, I replaced the iron pipe with a 30" Harrison monument stamped P.S. 13040.

**C. Description of monument for corner and accessories established to perpetuate locating the position of the corner:**

30" Harrison monument stamped P.S. 13040, marked with a carsonite sign post and is accepted as the best available evidence of the position of the original corner.  
Dbl. hd. nail & disc in SW. face of Elec. pole N 45° W 91.77  
Fd. nail & disc in SW. face of Elec. pole N 5° W 67.37  
Fd. nail & disc in West face of Elec. pole South 66.42  
Fd. nail & disc in East face of guy pole S 35° W 82.75  
Corner is 38 ft. South of Deerfield Road  
Corner is 28 ft. East of Lenawee Highway

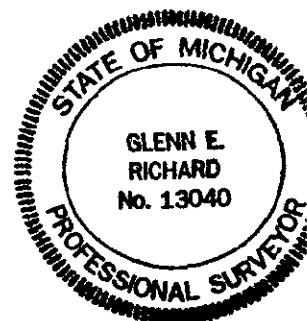

Ratified by Peer Group in accordance with P.A. 345 Co. Rep. Glenn E. Richard Date November 17, 1994  
Signed by Glenn E. Richard Date Nov. 25, 1994  
Glenn E. Richard

Surveyor's Michigan License No. 13040