

**SURVEY &  
REMONUMENTATION**

**JAN 15 1998**

**SECTION**

Filed under Remonumentation Act 345 of 1990 **LIBER 1 PAGE 207**  
**LAND CORNER RECORDATION CERTIFICATE**  
 Filing Requirement of Act 74, Mich. P.A. 1970

STATE OF MICHIGAN  
 LENAWEE COUNTY  
 FILED

17 OCT 97 3:54 P.M.

VICTORIA J. DANIELS  
 REGISTER OF DEEDS

Register of Deeds Stamp & File Number

For corners in

<u>Lenawee</u> (County)	Located In:	Corner Code #
1. Public Land Survey	T - 7 - S R - 4 - E	M - 7
	T _____ R _____	_____
	T _____ R _____	_____
	T _____ R _____	_____
2. Property Controlling in Section	S _____ T _____ R _____	_____
	S _____ T _____ R _____	_____
3. Miscellaneous Property in Sec	S _____ T _____ R _____	_____
	S _____ T _____ R _____	_____

4. Lot No. \_\_\_\_\_, Recorded Plat \_\_\_\_\_  
 5. Private Claims \_\_\_\_\_

I, Glenn E. Richard, in a field survey on September 04, 19 97, do hereby certify that under requirements of P.A. 74, Michigan P.A. of 1970, the corner points mentioned in lines 1 and 2 above were in conformance with regulations and rules therefore as required in the current manual of survey instructions of the United States Department of the Interior, Bureau of Land Management or by a decree of a Court of Law and/or that the corner points mentioned in lines 3, 4 and 5 above were in conformance with the rules of the Michigan Board of Land Surveyors or by a Decree of a Court of Law; established, re-established, monumented, re-monumented, recovered, found as expressed below:

	A	B	C	D	E	F	G	H	I	J	K	L	M
1													
2	6	5	4	3	2	1							
3													
4	7	8	9	10	11	12							
5													
6	18	17	16	15	14	13							
7													
8	19	20	21	22	23	24							
9													
10	30	29	28	27	26	25							
11													
12	31	32	33	34	35	36							
13													

NOTE: Not more than 4 corners, all in the same town and range, may be recorded on this certificate.

A. Description of original monument and accessories and/or subsequent restoration:

G.L.O. 1819 Joseph Fletcher set post cor. Sec. 13 & 24 Beech 30 N 46 W 23 Beech 12 N 87 E 18  
 1882 James Blair "Found Stake" 40 (26.40') links south of SW corner Section 18 T7S R5E  
 1889 James Blair Found Stake"  
 Early 1900's J.L. Richard records "stake"  
 1966 I dug and found stake and bricks and set 1/2" X 4' iron pipe. SW corner of house NE 140.75 NE corner of house SW 139.93


B. Description of corner evidence found and/or method applied in restoring or reestablishing corner:

Sept. 4, 1997 I found the 1/2 iron pipe and replaced it with a 3/4" X 3' iron pipe capped G.E.R. 13040  
 Sept. 6, 1997 Set monument box after Len. Co. Rd. Comm. layed new asphalt pavement.

C. Description of monument for corner and accessories established to perpetuate locating the position of the corner:

3/4" X 3' iron pipe capped G.E.R. 13040 in monument box and is accepted as the best available evidence of the position of the original corner.

SW corner of house foundation N 50° E 140.66  
 NE corner of house foundation S 45° W 139.85  
 Fd dbl hd nail & disc in E.P. East 32.92  
 Survey mark and Re-mon tag in E.P. N 40° W 47.27  
 3/4" iron pipe in monument box @ A-7 8-5 North 26.40'

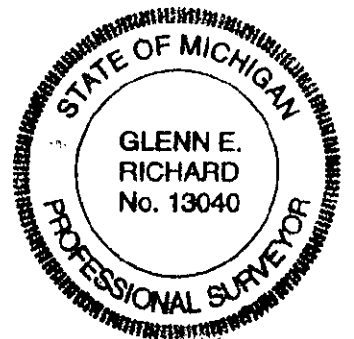

Ratified by Peer Group in accordance with P.A. 345 Co. Rep. Glenn E. Richard Date Sept. 30, 1997

Signed by Glenn E. Richard Date Oct. 7, 1997  
 Glenn E. Richard

Surveyor's Michigan License No. 13040