Filed under Remonumentation Act 345 of 1990

APR 0 1 1996 **LAND CORNER RECORDATION CERTIFICATE** LIBER **001** PAGE **86**

COMMISSION **Filing Requirement of Act 74, Mich. P.A. 1970**

For corners in

Lenawee (County)

	Located In:	Corner Code #
1. Public Land Survey	T-7-S R-5-E	F-1
	T___ R___	
	T___ R___	
	T___ R___	
2. Property Controlling	S___ T___ R___	
in Section	S___ T___ R___	
3. Miscellaneous	S___ T___ R___	
Property in Sec.	S___ T___ R___	

FILED 11:56 AM

NOV 22 1995

LENAWEE COUNTY
JEANETTE D. KNOX
REGISTER OF DEEDS

Register of Deeds Stamp & File Number

4. Lot No. _____, Recorded Plat _____
5. Private Claims _____

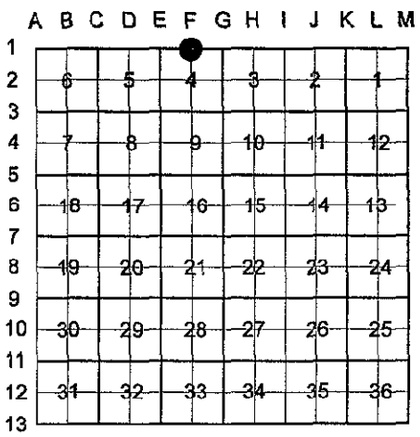

I, Glenn E. Richard, in a field survey on October 4 1995, do hereby certify that under requirements of P.A. 74, Michigan P.A. of 1970, the corner points mentioned in lines 1 and 2 above were in conformance with regulations and rules therefore as required in the current manual of survey instructions of the United States Department of the Interior, Bureau of Land Management or by a decree of a Court of Law and/or that the corner points mentioned in lines 3, 4 and 5 above were in conformance with the rules of the Michigan Board of Land Surveyors or by a Decree of a Court of Law; established, re-established, monumented, re-monumented, recovered, found as expressed below:

NOTE: Not more than 4 corners, all in the same town and range, may be recorded on this certificate.

A. Description of original monument and accessories and/or subsequent restoration:

G.L.O. This corner was not set on the original survey.
December 1884, James Blair found a very old stake and set iron and tile.
November 1975, I found 2" X 12" strap iron (sleigh shoe) 0.70 South of Town line.

B. Description of corner evidence found and/or method applied in restoring or reestablishing corner:

October 4, 1995, I found the sleigh shoe inside of a tile 45.10 feet East of F-13, T6S-R5E and 0.70 South of the Town line. Set 30" Harrison Monument stamped P.S. 13040 45.10 feet East of F-13 T6S-R5E on line between F-13 and G-13, T6S-R5E, 0.70 North of the sleigh shoe which was left in place.

C. Description of monument for corner and accessories established to perpetuate locating the position of the corner:

30" Harrison monument stamped P.S. 13040 This position not established by original government surveyors. This monument is accepted as the best available evidence of the position of the corner.
South 1/4 corner, Sec. 33 (F-13) T6S-R5E West 45.10
Southeast corner Sec. 33 (F-13) T6S-R5E East 2599.06
Stop sign post S 10° E 53.44
Stop sign post N 60° W 64.01
Dbl. hd. nail & disc in post next to tele. pedestal S 45° E 33.23

STATE OF MICHIGAN
GLENN E. RICHARD
No. 13040
PROFESSIONAL SURVEYOR

Ratified by Peer Group in accordance with P.A. 345 Co. Rep. Glenn E. Richard Date 10 - 19 - 95 .

Signed by Glenn E. Richard Date Nov. 2, 1995
Glenn E. Richard

Surveyor's Michigan License No. 13040

FORM APPROVED BY MICHIGAN STATE BOARD OF LAND SURVEYORS, JAN. 28, 1971

REVISED MAY 14, 1975
REVISED JAN., 1983
ADAPTED FOR WORD PROCESSING MARCH, 1993