

SURVEY & REMONUMENTATION

NOV 07 1994

COMMISSION

Filed under Remonumentation Act 345 of 1990

LAND CORNER RECORDATION CERTIFICATE

Filing Requirement of Act 74, Mich. P.A. 1970

LIDER **001** PAGE **01**

FILED

2:59 P.M.

OCT 10 1994

LENAWEE COUNTY
JEANETTE D. KNOX
REGISTER OF DEEDS

Register of Deeds Stamp & File Number

For corners in

Lenawee

(County)

Located In:

Corner Code #

- | | | |
|------------------------------------|--|-------------|
| 1. Public Land Survey | T <u>7</u> - S <u>5</u> R - <u>5</u> - E | <u>G-13</u> |
| | T _____ R _____ | _____ |
| | T _____ R _____ | _____ |
| | T _____ R _____ | _____ |
| 2. Property Controlling in Section | S _____ T _____ R _____ | _____ |
| | S _____ T _____ R _____ | _____ |
| 3. Miscellaneous Property in Sec. | S _____ T _____ R _____ | _____ |
| | S _____ T _____ R _____ | _____ |

4. Lot No. _____, Recorded Plat _____
5. Private Claims _____

	A	B	C	D	E	F	G	H	I	J	K	L	M
1													
2	6	5	4	3	2	1							
3													
4	7	8	9	10	11	12							
5													
6	18	17	16	15	14	13							
7													
8	19	20	21	22	23	24							
9													
10	30	29	28	27	26	25							
11													
12	31	32	33	34	35	36							
13													

I, Glenn E. Richard, in a field survey on Sept 19 1994, do hereby certify that under requirements of P.A. 74, Michigan P.A. of 1970, the corner points mentioned in lines 1 and 2 above were in conformance with regulations and rules therefore as required in the current manual of survey instructions of the United States Department of the Interior, Bureau of Land Management or by a decree of a Court of Law and/or that the corner points mentioned in lines 3, 4 and 5 above were in conformance with the rules of the Michigan Board of Land Surveyors or by a Decree of a Court of Law; established, re-established, monumented, re-monumented, recovered, found as expressed below:

NOTE: Not more than 4 corners, all in the same town and range, may be recorded on this certificate.

A. Description of original monument and accessories and/or subsequent restoration:


G.L.O. 1819, Joseph Fletcher set post W Oak 10 S 19 W 6, B Oak 12 N 84 W 31 October 28, 1886, On a survey dated October 28, 1886, by James Blair, the corner is described as a "stone close to North side of board fence". Survey records of J.L. Richard from early 1900's call for corner same as above with note "63.5 West of Riga corner". October 1955, I found a 3/4" iron bar during a survey going to the west. US-223 had been widened and the point is now in the bottom of the North ditch. September 1974, I set a 3/4" X 2" iron pipe by retracing 1955 survey and recorded it in L. 3, P. 37. The corner is on the south slope of the ditch along US-223.

B. Description of corner evidence found and/or method applied in restoring or reestablishing corner:

August 25, 1994, Found iron pipe as recorded.
September 19, 1994, replaced the iron pipe with a 30" Harrison monument stamped P.S. 13040 and marked with a carsonite post.

C. Description of monument for corner and accessories established to perpetuate locating the position of the corner:

30" Harrison monument stamped P.S. 13040 marked with a carsonite post, and is accepted as the best available evidence of the position of the original corner.
"X" cut on top conc. hdwl N 80° E 34.63
"X" cut on top conc hdwl S 75° E 96.93
SW corner house found. N 50° E 131.53
Dbl. hd. nail & disc in Elec Pole North 136.50
NE corner Section 4, T8S-R5E East 62.73

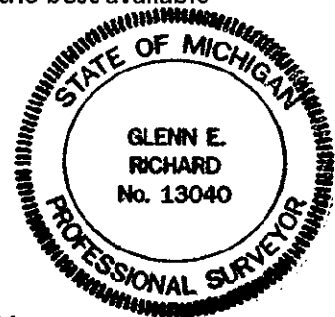

Ratified by Peer Group in accordance with P.A. 345 Co. Rep. Glenn E. Richard Date 9-15-94
Signed by Glenn E. Richard Date Oct 10, 1994
Glenn E. Richard

Surveyor's Michigan License No. 13040