

**SURVEY &
REMONUMENTATION**

NOV 07 1994

COMMISSION

Filed under Remonumentation Act 345 of 1990

LAND CORNER RECORDATION CERTIFICATE

Filing Requirement of Act 74, Mich. P.A. 1970

LIBER 001 PAGE 02

FILED

OCT 10 1994

2:59 P.M.

LENAWEE COUNTY
JEANETTE D. KNOX
REGISTER OF DEEDS

Register of Deeds Stamp & File Number

For corners in

<u>Lenawee</u>	Located In:	Corner Code #
(County)		
1. Public Land Survey	T - <u>7</u> - S R - <u>5</u> - E	<u>H-13</u>
	T _____ R _____	_____
	T _____ R _____	_____
	T _____ R _____	_____
2. Property Controlling in Section	S _____ T _____ R _____	_____
	S _____ T _____ R _____	_____
3. Miscellaneous Property in Sec.	S _____ T _____ R _____	_____
	S _____ T _____ R _____	_____

4. Lot No. _____, Recorded Plat _____
5. Private Claims _____

	A	B	C	D	E	F	G	H	I	J	K	L	M
1													
2	6	5	4	3	2	1							
3													
4	7	8	9	10	11	12							
5													
6	18	17	16	15	14	13							
7													
8	19	20	21	22	23	24							
9													
10	30	29	28	27	26	25							
11													
12	31	32	33	34	35	36							
13													

I, Glenn E. Richard, in a field survey on Sept 19 1994, do hereby certify that under requirements of P.A. 74, Michigan P.A. of 1970, the corner points mentioned in lines 1 and 2 above were in conformance with regulations and rules therefore as required in the current manual of survey instructions of the United States Department of the Interior, Bureau of Land Management or by a decree of a Court of Law and/or that the corner points mentioned in lines 3, 4 and 5 above were in conformance with the rules of the Michigan Board of Land Surveyors or by a Decree of a Court of Law; established, re-established, monumented, re-monumented, recovered, found as expressed below:

NOTE: Not more than 4 corners, all in the same town and range, may be recorded on this certificate.

A. Description of original monument and accessories and/or subsequent restoration:

G.L.O. 1819, Joseph Fletcher set post Sycamore 6 N 30E 14, Sycamore 20 N 25 E 14 Survey by James Blair dated 3-31-1882 states he found stake and bricks. Records of J.L. Richard from early 1900's call for "found stake and bricks". March 1958, I found bricks and stones and added a 1" iron pipe. May 12, 1976, I found piece of re-rod in the pavement which agreed with my notes of 1958 and recorded it in L. 3, P. 405.


B. Description of corner evidence found and/or method applied in restoring or reestablishing corner:

August 25, 1994, Found re-rod in pavement as recorded, which was inside of iron pipe 12" deep.
September 19, 1994, Removed re-rod and drove original iron pipe down with 3/4" X 3' iron pipe on top inside of monument box.

C. Description of monument for corner and accessories established to perpetuate locating the position of the corner:

3/4" X 3' iron pipe in monument box capped P.S. 13040, and is accepted as a careful and faithful perpetuation of the position of the original corner.

- "X" cut on 36" C.M.P. N 32° W 34.49
- "X" cut on 36" C.M.P. S 40° W 28.69
- "X" cut on 36" C.M.P. N 50° E 41.81
- "X" cut on 36" C.M.P. S 60° E 47.74
- N 1/4 corner, Sec 3, T8S-R5E, East 61.75

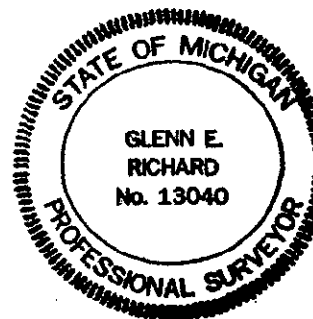

Ratified by Peer Group in accordance with P.A. 345 Co. Rep. Glenn E. Richard Date 9-15-94
Signed by Glenn E. Richard Date Oct. 10, 1994
Glenn E. Richard

Surveyor's Michigan License No. 13040