

**SURVEY &
REMONUMENTATION**

NOV 07 1994

COMMISSION

Filed under Remonumentation Act 345 of 1990

LAND CORNER RECORDATION CERTIFICATE

Filing Requirement of Act 74, Mich. P.A. 1970

LIBER **001** PAGE **03**

For corners in

Lenawee
(County)

Located in:

Corner Code #

- | | | |
|------------------------------------|--|-------------|
| 1. Public Land Survey | T <u>7</u> - S <u>5</u> R - E <u>5</u> - E | <u>1-13</u> |
| | T _____ R _____ | _____ |
| | T _____ R _____ | _____ |
| | T _____ R _____ | _____ |
| 2. Property Controlling in Section | S _____ T _____ R _____ | _____ |
| | S _____ T _____ R _____ | _____ |
| 3. Miscellaneous Property in Sec. | S _____ T _____ R _____ | _____ |
| | S _____ T _____ R _____ | _____ |

FILED

2:59 P.M.

OCT 10 1994

LENAWEE COUNTY
JEANETTE D. KNOX
REGISTER OF DEEDS

Register of Deeds Stamp & File Number

4. Lot No. _____, Recorded Plat _____
5. Private Claims _____

A B C D E F G H I J K L M

1														
2	6	5	4	3	2	1								
3														
4	7	8	9	10	11	12								
5														
6	18	17	16	15	14	13								
7														
8	19	20	21	22	23	24								
9														
10	30	29	28	27	26	25								
11														
12	31	32	33	34	35	36								
13														

I, Glenn E. Richard, in a field survey on Sept. 19 1994, do hereby certify that under requirements of P.A. 74, Michigan P.A. of 1970, the corner points mentioned in lines 1 and 2 above were in conformance with regulations and rules therefore as required in the current manual of survey instructions of the United States Department of the Interior, Bureau of Land Management or by a decree of a Court of Law and/or that the corner points mentioned in lines 3, 4 and 5 above were in conformance with the rules of the Michigan Board of Land Surveyors or by a Decree of a Court of Law; established, re-established, monumented, re-monumented, recovered, found as expressed below:

NOTE: Not more than 4 corners, all in the same town and range, may be recorded on this certificate.

A. Description of original monument and accessories and/or subsequent restoration:


G.L.O. 1819, Joseph Fletcher set post B. Ash 9 S 3 E 5, Elm 16 North 17
On survey by James Blair done March 31, 1882, he found stake, stones and bricks 82 3/4 links West of the stone at the Northeast corner of Section 3, T8S-R5E.
On a survey of Stadler Road done in 1958 the corner was gone as it fell in the South road ditch, but was determined from surveys by James Blair, to be 55.0 feet West of the NE corner of Sec 3, T8S-R5E.
March 30, 1976, We set an iron pipe 55.0 feet West from the NE corner of Sec 3, T8S-R5E on the extension of a line from the South 1/4 corner of Section 35, T7S-R5E, and recorded it in L. 3, P. 394.

B. Description of corner evidence found and/or method applied in restoring or reestablishing corner:

August 25, 1994, Found iron pipe as recorded one foot South of the pavement.
September 19, 1994, Replaced iron pipe with a 30" Harrison Monument, stamped P.S. 13040.

C. Description of monument for corner and accessories established to perpetuate locating the position of the corner:

Harrison monument stamped P.S. 13040, and is accepted as the best available evidence of the position of the original corner.
Dbl. hd. nail & disc in Elec Pole N 30° W 52.86
Dbl. hd. nail & disc in Elec Pole S 60° W 30.43
"X" cut on 6" C.M.P. N 10° W 39.15
"X" cut on 6" C.M.P. S 75° E 23.33
"X" cut on 6" C.M.P. S 70° E 92.73
"X" cut on 6" C.M.P. S 60° E 55.26
NE corner of Section 3, T8S-R5E, East 55.05

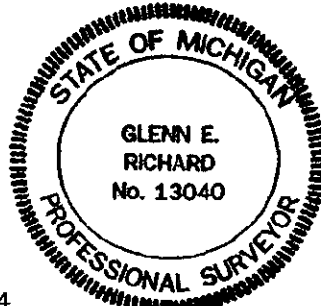

Ratified by Peer Group in accordance with P.A. 345 Co. Rep. Glenn E. Richard Date 9-15-94
Signed by Glenn E. Richard Date October 3, 1994
Glenn E. Richard
Surveyor's Michigan License No. 13040