

APR 01 1996

LAND CORNER RECORDATION CERTIFICATE

LIBER 001 PAGE 95

COMMISSION

Filing Requirement of Act 74, Mich. P.A. 1970

For corners in

Lenawee Located In: _____ Corner Code # _____
 (County)

1. Public Land Survey T 8-S R 1-E B-13
 T _____ R _____
 T _____ R _____
 T _____ R _____

2. Property Controlling S _____ T _____ R _____
 in Section S _____ T _____ R _____

3. Miscellaneous S _____ T _____ R _____
 Property in Sec. S _____ T _____ R _____

FILED

11:52 AM

NOV 22 1995

LENAWEE COUNTY
JEANETTE D. KNOX
REGISTER OF DEEDS

Register of Deeds Stamp & File Number

4. Lot No. _____, Recorded Plat _____
 5. Private Claims _____

	A	B	C	D	E	F	G	H	I	J	K	L	M
1													
2	6	5	4	3	2	1							
3													
4	7	8	9	10	11	12							
5													
6	18	17	16	15	14	13							
7													
8	19	20	21	22	23	24							
9													
10	30	29	28	27	26	25							
11													
12	31	32	33	34	35	36							
13													

I, Glenn E. Richard, in a field survey on September 25, 1995, do hereby certify that under requirements of P.A. 74, Michigan P.A. of 1970, the corner points mentioned in lines 1 and 2 above were in conformance with regulations and rules therefore as required in the current manual of survey instructions of the United States Department of the Interior, Bureau of Land Management or by a decree of a Court of Law and/or that the corner points mentioned in lines 3, 4 and 5 above were in conformance with the rules of the Michigan Board of Land Surveyors or by a Decree of a Court of Law; established, re-established, monumented, re-monumented, recovered, found as expressed below:


NOTE: Not more than 4 corners, all in the same town and range, may be recorded on this certificate.

A. Description of original monument and accessories and/or subsequent restoration:

G.L.O. June 1870, B. Kent surveyed SW 1/4 of Section 31. Notes state corner had been perpetuated by stones. September 1876, J. Blair surveyed for the road and called for large stone and used the corner again on a survey done in 1880. August 1977, W.E. Frazier & Associates set an iron pipe in line with the fence to the North by splitting the road fences and recorded it in Liber 4, Page 61


B. Description of corner evidence found and/or method applied in restoring or reestablishing corner:

September 25, 1995, Dug with back hoe and found large pointed stone 18" deep on north side of old wood stake and another granite stone on the east side of the pointed stone. Had to move the large pointed stone to the East to get a harrison monument in place of the wood stake.

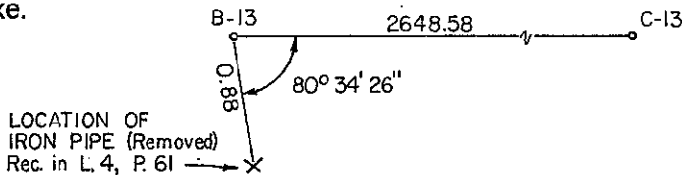

C. Description of monument for corner and accessories established to perpetuate locating the position of the corner:

30" Harrison monument stamped P.S. 13040 and is accepted as a careful and faithful perpetuation of the position of the original corner.
 SE corner of house foundation N 50° W 157.36
 NE corner of house foundation N 40° W 175.87
 DbI. hd. nail & disc in east face of Elec. pole S 30° W 72.04
 DbI. hd. nail & disc in west face of post North 26.76
 SE corner of Section 31, T8S-R1E, East 2648.58
 The corner is 2' ± North of gravel road center line and 7' East of a N and S C.M.P.

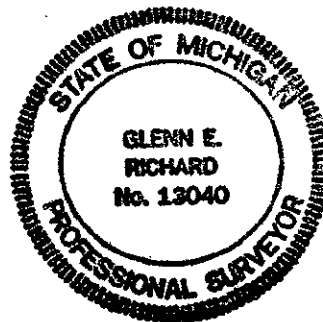

Ratified by Peer Group in accordance with P.A. 345 Co. Rep. Glenn E. Richard Date 10-19-95

Signed by Glenn E. Richard Date Nov. 3, 1995
 Glenn E. Richard

Surveyor's Michigan License No. 13040