

APR 6 1996

LAND CORNER RECORDATION CERTIFICATE
Filing Requirement of Act 74, Mich. P.A. 1970

COMMISSION

For corners in

Lenawee Located In: _____ Corner Code # _____
(County)

1. Public Land Survey T-8-S R-1-E C-8
T _____ R _____
T _____ R _____
T _____ R _____

2. Property Controlling S _____ T _____ R _____
in Section S _____ T _____ R _____

3. Miscellaneous S _____ T _____ R _____
Property in Sec. S _____ T _____ R _____

FILED

11:56 AM

NOV 22 1995

LENAWEE COUNTY
JEANETTE D. KNOX
REGISTER OF DEEDS

Register of Deeds Stamp & File Number

4. Lot No. _____ Recorded Plat _____
5. Private Claims _____

	A	B	C	D	E	F	G	H	I	J	K	L	M
1													
2	6	5	4	3	2	1							
3													
4	7	8	9	10	11	12							
5													
6	18	17	16	15	14	13							
7													
8	19	20	21	22	23	24							
9													
10	30	29	28	27	26	25							
11													
12	31	32	33	34	35	36							
13													

I, Glenn E. Richard, in a field survey on JULY 13, 1995, do hereby certify that under requirements of P.A. 74, Michigan P.A. of 1970, the corner points mentioned in lines 1 and 2 above were in conformance with regulations and rules therefore as required in the current manual of survey instructions of the United States Department of the Interior, Bureau of Land Management or by a decree of a Court of Law and/or that the corner points mentioned in lines 3, 4 and 5 above were in conformance with the rules of the Michigan Board of Land Surveyors or by a Decree of a Court of Law; established, re-established, monumented, re-monumented, recovered, found as expressed below:

NOTE: Not more than 4 corners, all in the same town and range, may be recorded on this certificate.

A. Description of original monument and accessories and/or subsequent restoration:


G.L.O. March 20, 1824 Ziba Swan set 1/4 Sec. post B. Oak 20 S 46° W 14 Elm 14 N 2° E 10
1918 J.L. Richard surveyed Munson Hwy. "W 1/4 post Sec 292" Didn't described any monument. property line R. & L.
April 1966 I couldn't find anything for the corner. I set an iron pipe in line of fences, East and West by doubling the distance between the fence at the Center of Sec. 20 and the West 1/8 line.
October 1980, Werner Sommer found the iron pipe and recorded it in Liber 4, Page 386 Dbl. hd. nail & disc in E.P. N 80° W 68.58
May 25, 1993, I found the 1/2" iron pipe, Dbl. hd. nail & disc in E.P. N 85° W 68.53

B. Description of corner evidence found and/or method applied in restoring or reestablishing corner:

July 13, 1995, Found the 1/2" iron pipe under first course of new asphalt pavement. Replaced it with a 3/4" X 3' iron pipe capped G.E.R. P.S. 13040 and set monument box.

C. Description of monument for corner and accessories established to perpetuate locating the position of the corner:

3/4" X 3' iron pipe capped G.E.R. P.S. 13040 in monument box and is accepted as the best available evidence of the position of the original corner.
Dbl. hd. nail & disc in Elec. pole N 85° W 68.53
Set re-rod N 45° W 44.01
Set re-rod N 35° E 43.63 next to wood post
Set re-rod East 72.75 next to steel post
Section corner South 2801.80
The corner is 1.5 East of the pavement center line.

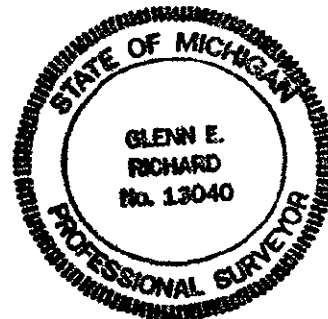

Ratified by Peer Group in accordance with P.A. 345 Co. Rep. Glenn E. Richard Date 9-18-95.

Signed by Glenn E. Richard Date 10-9-95
Glenn E. Richard

Surveyor's Michigan License No. 13040