

APR 6 1996

COMMISSION

Filed under Remonumentation Act 345 of 1990
LAND CORNER RECORDATION CERTIFICATE
Filing Requirement of Act 74, Mich. P.A. 1970

LIBER 001 PAGE 94

For corners in

Lenawee
(County)

Located In:

Corner Code #

- 1. Public Land Survey T -8-S R -1-E C-11
T _____ R _____
T _____ R _____
T _____ R _____
- 2. Property Controlling S _____ T _____ R _____
in Section S _____ T _____ R _____
- 3. Miscellaneous S _____ T _____ R _____
Property in Sec. S _____ T _____ R _____

FILED

NOV 22 1995

11:56 A.M.

LENAWEE COUNTY
JEANETTE D. KNOX
REGISTER OF DEEDS

Register of Deeds Stamp & File Number

- 4. Lot No. _____, Recorded Plat _____
- 5. Private Claims _____

	A	B	C	D	E	F	G	H	I	J	K	L	M
1													
2	6	5	4	3	2	1							
3													
4	7	8	9	10	11	12							
5													
6	16	17	18	15	14	13							
7													
8	19	20	21	22	23	24							
9													
10	30	29	28	27	26	25							
11													
12	31	32	33	34	35	36							
13													

I, Glenn E. Richard, in a field survey on JULY 12 1995, do hereby certify that under requirements of P.A. 74, Michigan P.A. of 1970, the corner points mentioned in lines 1 and 2 above were in conformance with regulations and rules therefore as required in the current manual of survey instructions of the United States Department of the Interior, Bureau of Land Management or by a decree of a Court of Law and/or that the corner points mentioned in lines 3, 4 and 5 above were in conformance with the rules of the Michigan Board of Land Surveyors or by a Decree of a Court of Law; established, re-established, monumented, re-monumented, recovered, found as expressed below:

NOTE: Not more than 4 corners, all in the same town and range, may be recorded on this certificate.

A. Description of original monument and accessories and/or subsequent restoration:


G.L.O. March 2, 1824 Ziba Swan set post com. Sec. 29, 30, 31, and 32 Elm 20 N 10° E 9 Elm 24 S 52° 17 1918 ± J.L. Richard surveyed Munson Hwy. "Found stone and bricks" Northwest corner of School house S 32° E 124.9
March 1, 1968 Werner Sommer and I dug and found stone 12" below the pavement surface and set iron pipe over stone.
May 25, 1993 Pavement had been scarified. Found 1/2" X 12" iron pipe bent. Found flat stone under it and circle of stones and bricks with remains of wood stake in the middle. Set 3/4" X 3' gas pipe capped G.E.R. P.S. 13040

B. Description of corner evidence found and/or method applied in restoring or reestablishing corner:

July 12, 1995 found 3/4" gas pipe under first course of new asphalt pavement and set monument box.

C. Description of monument for corner and accessories established to perpetuate locating the position of the corner:

3/4" X 3' gas pipe capped G.E.R. P.S. 13040 in monument box and is accepted as the best available evidence of the position of the original corner.
Northwest corner of original brick School house S 20° E 124.62
Southwest corner of original brick School house S 15° E 173.26
"X" cut on North end C.M.P. N 45° E 34.60
"X" cut on South end C.M.P. S 45° E 30.12
Re-rod on Section line West 50.02
Re-rod on Section line West 200.37
1/4 corner West 2653.69
The corner is in the center line of the pavement.

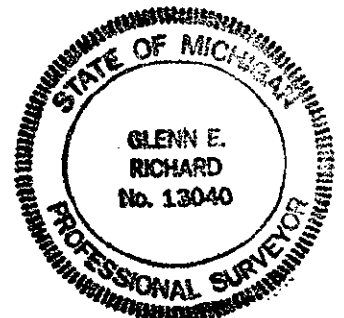

Ratified by Peer Group in accordance with P.A. 345 Co. Rep. Glenn E. Richard Dated 9-18-95.

Signed by Glenn E. Richard Date 10-3-95
Glenn E. Richard

Surveyor's Michigan License No. 13040