

LAND CORNER RECORDATION CERTIFICATE

Filing Requirement of Act 74, Mich. P.A. 1970

APR 01 1996

COMMISSION

FILED

11:56 AM

NOV 22 1995

LENAWEE COUNTY
JEANETTE D. KNOX
REGISTER OF DEEDS

For corners in

<u>Lenawee</u>	Located In:	Corner Code #
(County)		
1. Public Land Survey	T - 8 - S R - 1 - E	C-12
	T _____ R _____	_____
	T _____ R _____	_____
	T _____ R _____	_____
2. Property Controlling in Section	S _____ T _____ R _____	_____
	S _____ T _____ R _____	_____
3. Miscellaneous Property in Sec.	S _____ T _____ R _____	_____
	S _____ T _____ R _____	_____

Register of Deeds Stamp & File Number

4. Lot No. _____, Recorded Plat _____

5. Private Claims _____

	A	B	C	D	E	F	G	H	I	J	K	L	M
1													
2	6	5	4	3	2	1							
3													
4	7	8	9	10	11	12							
5													
6	18	17	16	15	14	13							
7													
8	19	20	21	22	23	24							
9													
10	30	29	28	27	26	25							
11													
12	31	32	33	34	35	36							
13													

I, Glenn E. Richard, in a field survey on Sept. 26, 1995, do hereby certify that under requirements of P.A. 74, Michigan P.A. of 1970, the corner points mentioned in lines 1 and 2 above were in conformance with regulations and rules therefore as required in the current manual of survey instructions of the United States Department of the Interior, Bureau of Land Management or by a decree of a Court of Law and/or that the corner points mentioned in lines 3, 4 and 5 above were in conformance with the rules of the Michigan Board of Land Surveyors or by a Decree of a Court of Law; established, re-established, monumented, re-monumented, recovered, found as expressed below:

NOTE: Not more than 4 corners, all in the same town and range, may be recorded on this certificate.

A. Description of original monument and accessories and/or subsequent restoration:


G.L.O. March 20, 1824 Ziba Swan set 1/4 post Beech 14 S 12° W 17 Beech 22 N 19° E 18
 June 1870 Burton Kent did a survey in Section 31 and shows a distance from the Center of the section to the East 1/4 corner but doesn't described the monument. The distance from the occupied Center to the east line of the section (line between Section corners) measures 2655.5. Kent record 39.89 chains = 2632.74
 No North-South distances on east line of Section on the Kent survey.

B. Description of corner evidence found and/or method applied in restoring or reestablishing corner:

No visible lines East or West.
 September 26, 1995, set 3/4" X 3' gas pipe in monument box midway and on line between Section corners to North and South.

C. Description of monument for corner and accessories established to perpetuate locating the position of the corner:

3/4" X 3' gas pipe capped G.E.R. P.S. 13040 in monument box This monument is accepted as the best available evidence of the position of the original corner.
 Dbl. hd. nail & disc in Elec. pole N 85° W 91.85
 Dbl. hd. nail & disc in post next to Tel. pedestal S 10° W 194.77
 "X" cut on top of bee hive catch basin S 5° W 321.71
 "X" cut on top of bee hive catch basin S 10° E 320.64
 Section corner North 2654.59
 Section corner South 2654.59
 The corner is 6' East of the pavement center line

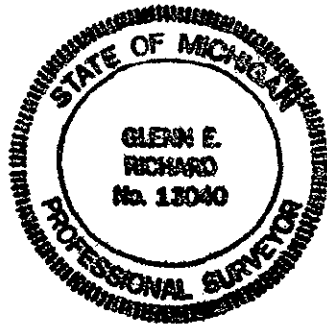

Ratified by Peer Group in accordance with P.A. 345 Co. Rep. Glenn E. Richard Date 9-18-95.

Signed by Glenn E. Richard Date 10-9-95

Glenn E. Richard

Surveyor's Michigan License No. 13040