

SURVEY & REMONUMENTATION

Filed under Remonumentation Act 345 of 1990

NOV 13 1995

LAND CORNER RECORDATION CERTIFICATE

LIBER 001 PAGE 71

COMMISSION

Filing Requirement of Act 74, Mich. P.A. 1970

For corners in

Lenawee Located In: _____ Corner Code # _____
 (County)

1. Public Land Survey T-8-S R-1-E C-13
 T_____ R_____
 T_____ R_____
 T_____ R_____
 T_____ R_____

2. Property Controlling S_____ T_____ R_____
 in Section S_____ T_____ R_____
 S_____ T_____ R_____

3. Miscellaneous S_____ T_____ R_____
 Property in Sec. S_____ T_____ R_____

FILED

OCT 09 1995

LENAWEE COUNTY
 JEANETTE D. KNOX
 REGISTER OF DEEDS

Register of Deeds Stamp & File Number

4. Lot No. _____, Recorded Plat _____
 5. Private Claims _____

	A	B	C	D	E	F	G	H	I	J	K	L	M
1													
2	6	5	4	3	2	1							
3													
4	7	8	9	10	11	12							
5													
6	13	17	16	15	14	13							
7													
8	19	20	21	22	23	24							
9													
10	30	29	28	27	26	25							
11													
12	31	32	33	34	35	36							
13													

I, Glenn E. Richard, in a field survey on July 13 1995, do hereby certify that under requirements of P.A. 74, Michigan P.A. of 1970, the corner points mentioned in lines 1 and 2 above were in conformance with regulations and rules therefore as required in the current manual of survey instructions of the United States Department of the Interior, Bureau of Land Management or by a decree of a Court of Law and/or that the corner points mentioned in lines 3, 4 and 5 above were in conformance with the rules of the Michigan Board of Land Surveyors or by a Decree of a Court of Law; established, re-established, monumented, re-monumented, recovered, found as expressed below:

NOTE: Not more than 4 corners, all in the same town and range, may be recorded on this certificate.

A. Description of original monument and accessories and/or subsequent restoration:


G.L.O. March 2, 1824 John Mullet set post com. Sec. 31 & 32 Hickory 24 N 85° W 44 Beech 8 N 85° E 17 September 1876 and October 1885 J. Blair surveyed the road going west and called for a stone at the corner. 1918 ± J.L. Richard surveyed the road going north and his noted called for stone and the same witnesses as the Blair survey. August 18, 1966 I dug for the stone using the stump of one of the witnesses but didn't find anything. Set 1/2" X 3' iron pipe using the bearing (N 22 1/2° E) and distance (50 1/2 links) from the W. Ash stump. August 24, 1977 K.L. Suydam found the iron pipe and recorded it in Liber 4, Page 61.

B. Description of corner evidence found and/or method applied in restoring or reestablishing corner:

July 13, 1995 Found the 1/2" iron pipe under first course of asphalt pavement, replaced with 3/4" X 3' gas pipe capped G.E.R. P.S. 13040 and set monument box.

-C. Description of monument for corner and accessories established to perpetuate locating the position of the corner:

3/4" X 3' gas pipe capped G.E.R. P.S. 13040 in monument box and is accepted as the best available evidence of the position of the original corner.
 Northwest corner of house S 50° W 116.79
 Northeast corner of garage S 30° W 124.00
 Dbl. hd. nail and disc in 20" Catalpa S 45° E 45.48
 Dbl. hd. nail and disc in stub of pole N 50° E 38.21
 Northeast corner of Sec. 6, Town 9 South, Range 1 East, West 204.60
 The corner is 2' North and 2' East of the pavement center lines.

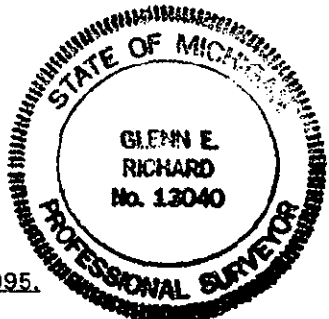

Ratified by Peer Group in accordance with P.A. 345 Co. Rep. Glenn E. Richard Date September 18, 1995.

Signed by Glenn E. Richard Date 9-28-95
 Glenn E. Richard

Surveyor's Michigan License No. 13040