

SURVEY & REMONUMENTATION

APR 28 1995

COMMISSION

Filed under Remonumentation Act 345 of 1990

LAND CORNER RECORDATION CERTIFICATE

Filing Requirement of Act 74, Mich. P.A. 1970

LIBER 001 PAGE 44

For corners in

| | | |
|------------------------------------|----------------------|---------------|
| <u>Lenawee</u> | Located In: | Corner Code # |
| (County) | | |
| 1. Public Land Survey | T-8-S R-2-E | K-5 |
| | T_____ R_____ | _____ |
| | T_____ R_____ | _____ |
| | T_____ R_____ | _____ |
| 2. Property Controlling in Section | S_____ T_____ R_____ | _____ |
| | S_____ T_____ R_____ | _____ |
| 3. Miscellaneous Property in Sec. | S_____ T_____ R_____ | _____ |
| | S_____ T_____ R_____ | _____ |

FILED
 DEC 05 1994
 2:01 P.M.
 LENAWEE COUNTY
 JEANETTE D. KNOX
 REGISTER OF DEEDS
 Register of Deeds Stamp & File Number

4. Lot No. _____, Recorded Plat _____
 5. Private Claims _____

I, Glenn E. Richard, in a field survey on November 10 1994 do hereby certify that under requirements of P.A. 74, Michigan P.A. of 1970, the corner points mentioned in lines 1 and 2 above were in conformance with regulations and rules therefore as required in the current manual of survey instructions of the United States Department of the Interior, Bureau of Land Management or by a decree of a Court of Law and/or that the corner points mentioned in lines 3, 4 and 5 above were in conformance with the rules of the Michigan Board of Land Surveyors or by a Decree of a Court of Law; established, re-established, monumented, re-monumented, recovered, found as expressed below:

| | | | | | | | | | | | | | |
|----|----|----|----|----|----|----|---|---|---|---|---|---|---|
| | A | B | C | D | E | F | G | H | I | J | K | L | M |
| 1 | | | | | | | | | | | | | |
| 2 | 6 | 5 | 4 | 3 | 2 | 1 | | | | | | | |
| 3 | | | | | | | | | | | | | |
| 4 | 7 | 8 | 9 | 10 | 11 | 12 | | | | | | | |
| 5 | | | | | | | | | | | | | |
| 6 | 18 | 17 | 16 | 15 | 14 | 13 | | | | | | | |
| 7 | | | | | | | | | | | | | |
| 8 | 19 | 20 | 21 | 22 | 23 | 24 | | | | | | | |
| 9 | | | | | | | | | | | | | |
| 10 | 30 | 29 | 28 | 27 | 26 | 25 | | | | | | | |
| 11 | | | | | | | | | | | | | |
| 12 | 31 | 32 | 33 | 34 | 35 | 36 | | | | | | | |
| 13 | | | | | | | | | | | | | |

NOTE: Not more than 4 corners, all in the same town and range, may be recorded on this certificate.

A. Description of original monument and accessories and/or subsequent restoration:


G.L.O. March 1824, John Mullett set post Cor. Sections 11, 12, 13 & 14, W. Wood 40 S 51 W 24, B. Oak 28 N 29 E 47
 December 1886, Survey by James Blair called for stone.
 April 1940, Harold Clegg, R.L.S. 13578, found the stone and set iron 33' North and irons SE. & SW. 33' from centerlines.
 January 16, 1969, I found the iron pipe on the SW corner and the stone and set monument box over it.
 September 1972, I found the stone in the monument box and recorded it in L. 1, P. 617.

B. Description of corner evidence found and/or method applied in restoring or reestablishing corner:

November 10, 1994, Dug and found 3/4" X 12" re-rod in the monument box 8" below surface of new asphalt pavement, which checked the two remaining witnesses.
 Dug out existing monument box and raised to surface. Drilled hole in the stone and set 5/8" X 17" re-rod in the stone and replaced the box.

C. Description of monument for corner and accessories established to perpetuate locating the position of the corner:

5/8" X 17" re-rod in stone inside of monument box capped G.E.R., P.S. 13040, and is accepted as the best available evidence of the position of the original corner.
 Fd. dbl. hd. nail & disc in Northwest face 42" Oak S 50° W 78.35
 Fd. dbl. hd. nail & disc in West face Elec. pole N 25° W 63.73
 Fd. dbl. hd. nail & disc in East face 28" Oak N 15° W 109.18
 Fd. dbl. hd. nail & disc in West face guy pole S 10° E 132.70
 Cut "X" on East end of C.M.P. S 30° E 39.06
 Cut "X" on Southwest face of 3" galv. post N 45° E 68.75

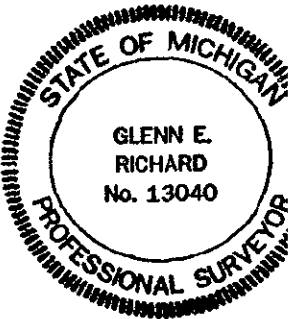

Ratified by Peer Group in accordance with P.A. 345 Co. Rep. Glenn E. Richard Date November 17, 1994
 Signed by Glenn E. Richard Date Nov. 25, 1994
 Glenn E. Richard
 Surveyor's Michigan License No. 13040