

**SURVEY &
REMONUMENTATION**

APR 28 1995

COMMISSION

Filed under Remonumentation Act 345 of 1990

LAND CORNER RECORDATION CERTIFICATE

Filing Requirement of Act 74, Mich. P.A. 1970

LIBER 001 PAGE 43

For corners in

Lenawee
(County)

Located In:

Corner Code #

- | | | |
|------------------------------------|--|------------|
| 1. Public Land Survey | T <u>8</u> - S <u>2</u> R - <u>2</u> - E | <u>L-5</u> |
| | T _____ R _____ | _____ |
| | T _____ R _____ | _____ |
| | T _____ R _____ | _____ |
| 2. Property Controlling in Section | S _____ T _____ R _____ | _____ |
| | S _____ T _____ R _____ | _____ |
| 3. Miscellaneous Property in Sec. | S _____ T _____ R _____ | _____ |
| | S _____ T _____ R _____ | _____ |

FILED
DEC 05 1994 2:01 P.M.
LENAWEE COUNTY
JEANETTE D. INOX
REGISTER OF DEEDS
Register of Deeds Stamp & File Number

4. Lot No. _____, Recorded Plat _____
5. Private Claims _____

	A	B	C	D	E	F	G	H	I	J	K	L	M
1													
2	6	5	4	3	2	1							
3													
4	7	8	9	10	11	12							
5													
6	18	17	16	15	14	13							
7													
8	19	20	21	22	23	24							
9													
10	30	29	28	27	26	25							
11													
12	31	32	33	34	35	36							
13													

I, Glenn E. Richard, in a field survey on November 10 1994, do hereby certify that under requirements of P.A. 74, Michigan P.A. of 1970, the corner points mentioned in lines 1 and 2 above were in conformance with regulations and rules therefore as required in the current manual of survey instructions of the United States Department of the Interior, Bureau of Land Management or by a decree of a Court of Law and/or that the corner points mentioned in lines 3, 4 and 5 above were in conformance with the rules of the Michigan Board of Land Surveyors or by a Decree of a Court of Law; established, re-established, monumented, re-monumented, recovered, found as expressed below:

NOTE: Not more than 4 corners, all in the same town and range, may be recorded on this certificate.

A. Description of original monument and accessories and/or subsequent restoration:


G.L.O. March 1824, John Mullett set 1/4 post B. Oak 30 S 45 W 28, W. Ash 8 N 40 E 27
April 1886, James Blair found corner and described the corner as "Stones" and again on a survey dated Dec. 1886.
April 1940, Harold Clegg, R.L.S. 13578, "found corner, set irons 33' North and 33' South".
April 1958, I found a sq. hd. bolt and an iron pipe 33.00 feet North and raised with a spike.
July 1972, W.E. Frazier & Assoc. found boat spike and raised with 12" iron pipe.

B. Description of corner evidence found and/or method applied in restoring or reestablishing corner:

November 10, 1994, Found 3/4" X 12" iron pipe under 9" of new asphalt. Removed the existing iron pipe and set 3/4" X 3' iron pipe capped G.E.R., P.S. 13040 in monument box. I hit the stones at 2' ± and had to bend the new iron pipe to be at the point after getting the iron pipe through the stones

C. Description of monument for corner and accessories established to perpetuate locating the position of the corner:

3/4" X 3' iron pipe capped G.E.R., P.S. 13040 in monument box and is accepted as the best available evidence of the position of the original corner.
Fd. iron pipe capped W.F.A. 17636 South 33.04
Fd. iron pipe North 33.01
Cut "X" on West end C.M.P. N 70° W 53.24
Dbl. hd. nail & disc in east face 36" Oak N 10° E 27.45
Dbl. hd. nail & disc in Elec. pole S 80° W 204.05
NW. corner of conc. blk. foundation of most Westerly part of house S 70° E 277.18

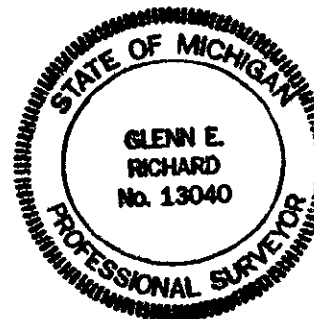

Ratified by Peer Group in accordance with P.A. 345 Co. Rep. Glenn E. Richard Date November 17, 1994
Signed by Glenn E. Richard Date Nov. 25, 1994
Glenn E. Richard

Surveyor's Michigan License No. 13040