

APR 01 1996

LAND CORNER RECORDATION CERTIFICATE

Filing Requirement of Act 74, Mich. P.A. 1970

COMMISSION

For corners in

Lenawee Located In: \_\_\_\_\_ Corner Code # \_\_\_\_\_  
 (County)

1. Public Land Survey T 8 S R 3 E F-5  
 T \_\_\_\_\_ R \_\_\_\_\_  
 T \_\_\_\_\_ R \_\_\_\_\_  
 T \_\_\_\_\_ R \_\_\_\_\_

2. Property Controlling S \_\_\_\_\_ T \_\_\_\_\_ R \_\_\_\_\_  
 in Section S \_\_\_\_\_ T \_\_\_\_\_ R \_\_\_\_\_

3. Miscellaneous S \_\_\_\_\_ T \_\_\_\_\_ R \_\_\_\_\_  
 Property in Sec. S \_\_\_\_\_ T \_\_\_\_\_ R \_\_\_\_\_

FILED

12:09 P.M.

NOV 21 1995

LENAWEE COUNTY  
JEANETTE D. KNOX  
REGISTER OF DEEDS

Register of Deeds Stamp & File Number

4. Lot No. \_\_\_\_\_, Recorded Plat \_\_\_\_\_  
 5. Private Claims \_\_\_\_\_

	A	B	C	D	E	F	G	H	I	J	K	L	M
1													
2	6	5	4	3	2	1							
3													
4	7	8	9	10	11	12							
5													
6	18	17	16	15	14	13							
7													
8	19	20	21	22	23	24							
9													
10	30	29	28	27	26	25							
11													
12	31	32	33	34	35	36							
13													

I, Glenn E. Richard, in a field survey on June 28 1995, do hereby certify that under requirements of P.A. 74, Michigan P.A. of 1970, the corner points mentioned in lines 1 and 2 above were in conformance with regulations and rules therefore as required in the current manual of survey instructions of the United States Department of the Interior, Bureau of Land Management or by a decree of a Court of Law and/or that the corner points mentioned in lines 3, 4 and 5 above were in conformance with the rules of the Michigan Board of Land Surveyors or by a Decree of a Court of Law; established, re-established, monumented, re-monumented, recovered, found as expressed below:

NOTE: Not more than 4 corners, all in the same town and range, may be recorded on this certificate.

A. Description of original monument and accessories and/or subsequent restoration:


G.L.O. March 1824 John Mullett Elm 20 for quarter Section corner (no witnesses)  
 Couldn't find any record of anyone ever finding or re-establishing this corner prior to 1972.

B. Description of corner evidence found and/or method applied in restoring or reestablishing corner:

March 1972, W.E. Frazier and Associates set 3/8" X 1 1/2" flat iron bar in line of fence South, face of post South 24.87  
 June 1995, found 3/8" X 1 1/2" flat iron bar  
 October 12, 1995, Replaced iron bar with 30" Harrison monument stamped P.S. 13040. Also found 3" to 6" X 4" sand stone 2' deep. The largest one was on end with a pointed corner 0.2 SW of top of 3/8" X 1 1/2" iron bar.

C. Description of monument for corner and accessories established to perpetuate locating the position of the corner:

30" Harrison Monument stamped P.S. 13040 and is accepted as the best available evidence of the position of the original corner.  
 Dbl. hd. nail & disc in E.P. N 45° W 37.04  
 Dbl. hd. nail & disc in E.P. N 85° W 288.83  
 Dbl. hd. nail & disc in E.P. S 15° E 23.92  
 NE corner of pole barn S 80° W 398.15

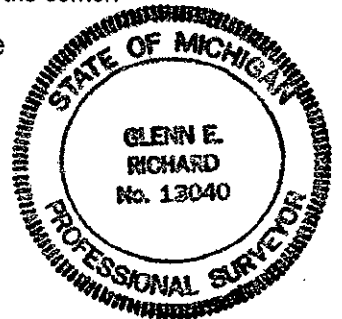

Ratified by Peer Group in accordance with P.A. 345 Co. Rep. Glenn E. Richard Date 9-18-95

Signed by Glenn E. Richard Date Nov. 2, 1995  
 Glenn E. Richard

Surveyor's Michigan License No. 13040