

APR 01 1996

LAND CORNER RECORDATION CERTIFICATE

Filing Requirement of Act 74, Mich. P.A. 1970

COMMISSION

For corners in

Lenawee

(County)

Located In:

Corner Code #

- 1. Public Land Survey T-8-S R-3-E G-4
T R
T R
T R
- 2. Property Controlling S T R
in Section S T R
- 3. Miscellaneous S T R
Property in Sec. S T R

FILED

NOV 21 1995

12:09 P.M.

LENAWEE COUNTY
JEANETTE D. KNOX
REGISTER OF DEEDS

Register of Deeds Stamp & File Number

- 4. Lot No. _____, Recorded Plat _____
- 5. Private Claims _____

A B C D E F G H I J K L M

1													
2	6	5	4	3	2	1							
3													
4	7	8	9	10	11	12							
5													
6	18	17	16	15	14	13							
7													
8	19	20	21	22	23	24							
9													
10	30	29	28	27	26	25							
11													
12	31	32	33	34	35	36							
13													

I, Glenn E. Richard, in a field survey on July 14 1995, do hereby certify that under requirements of P.A. 74, Michigan P.A. of 1970, the corner points mentioned in lines 1 and 2 above were in conformance with regulations and rules therefore as required in the current manual of survey instructions of the United States Department of the Interior, Bureau of Land Management or by a decree of a Court of Law and/or that the corner points mentioned in lines 3, 4 and 5 above were in conformance with the rules of the Michigan Board of Land Surveyors or by a Decree of a Court of Law; established, re-established, monumented, re-monumented, recovered, found as expressed below:

NOTE: Not more than 4 corners, all in the same town and range, may be recorded on this certificate.

A. Description of original monument and accessories and/or subsequent restoration:


G.L.O. March 1824 John Mullett set quarter post for Sections 9 & 10 Hickory 7 N 40° E 22 sycamore 18 S 69° W 21 Couldn't find any records of anyone ever finding or re-establishing this corner.

B. Description of corner evidence found and/or method applied in restoring or reestablishing corner:

July 1995, I re-established this corner using Single Proportionate method between the NE and SE corners of Section 9 Set 3/4" x 2' gas pipecapped G.E.R. P.S. 13040 October 12, 1995, Replace iron pipe with a 30" Harrison Monument stamped P.S. 13040

C. Description of monument for corner and accessories established to perpetuate locating the position of the corner:

30" Harrison Monument stamped P.S. 13040 and is accepted as the best available evidence of the position of the original corner.
Dbl. hd. nail & disc in E. P. N 25° W 74.05
"X" cut on S. end C.M.P. S 85° W 22.79
"X" cut on S. end C.M.P. S 30° E 26.89
"X" cut on N. end C.M.P. N 20° E 37.04

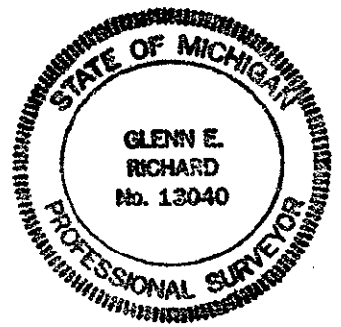

Ratified by Peer Group in accordance with P.A. 345 Co. Rep. Glenn E. Richard Date 9-18-95

Signed by Glenn E. Richard Date _____
Glenn E. Richard

Surveyor's Michigan License No. 13040