APR 0 1 1996

COMMISSION

Filed under Remonumentation Act 345 of 1990

LAND CORNER RECORDATION CERTIFICATE

Filing Requirement of Act 74, Mich. P.A. 1970

LIBER **001** PAGE **97**

FILED

DEC 2 8 1995 1:51 P.M.

LENAWEE COUNTY
JEANETTE D. KNOX
REGISTER OF DEEDS

Register of Deeds Stamp & File Number

For corners in

Lenawee (County)

		Located In:	Corner Code #
1. Public Land Survey		T-8-S R-4-E	B-3
		T___ R___	
		T___ R___	
		T___ R___	
2. Property Controlling	S___	T___ R___	
in Section	S___	T___ R___	
3. Miscellaneous	S___	T___ R___	
Property in Sec.	S___	T___ R___	

4. Lot No. _____, Recorded Plat _____
5. Private Claims _____

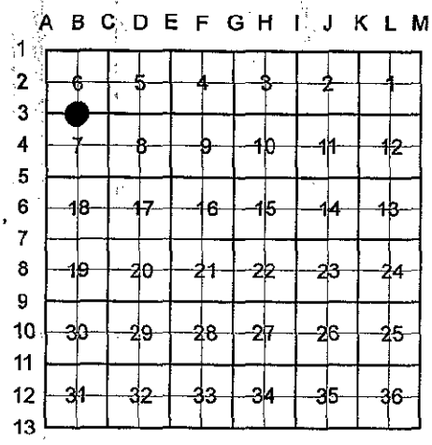

I, Glenn E. Richard, in a field survey on Dec. 5 19 95, do hereby certify that under requirements of P.A. 74, Michigan P.A. of 1970, the corner points mentioned in lines 1 and 2 above were in conformance with regulations and rules therefore as required in the current manual of survey instructions of the United States Department of the Interior, Bureau of Land Management or by a decree of a Court of Law and/or that the corner points mentioned in lines 3, 4 and 5 above were in conformance with the rules of the Michigan Board of Land Surveyors or by a Decree of a Court of Law; established, re-established, monumented, re-monumented, recovered, found as expressed below:

NOTE: Not more than 4 corners, all in the same town and range, may be recorded on this certificate.

A. Description of original monument and accessories and/or subsequent restoration:

G.L.O. 1827, Robert Clark set 1/4 post Ash 40 N 14 E 6, Ironwood 11 S 20 E 3.
J.L. Richard records from the early 1900's called for a stone pump and iron .
October 24, 1962, K.L. Suydam found 1/2" X 2' iron strap and stone pump 36" deep and raised with 3/4" X 30" iron pipe.
April 1970, I found the iron pipe 12" deep and raised with iron pipe.
February 1977, I found the iron pipe and recorded it in L. 3, P. 532.
August 1989, Found iron pipe as recorded prior to new bridge construction.

B. Description of corner evidence found and/or method applied in restoring or reestablishing corner:

December 5, 1995, I dug through a new pavement and found 1/2" X 12" iron pipe (bent) in top of 3/4" X 30" iron pipe. Removed them and set 3/4" X 3' gas pipe in monument box.

C. Description of monument for corner and accessories established to perpetuate locating the position of the corner:

3/4" X 3' gas pipe capped G.E.R., P.S. 13040 in monument box and is accepted as the best available evidence of the position of the original corner.
Dbl. hd. nail & disc in 16" Ash S 70° W 91.86
Dbl. hd. nail & disc in Elec. Pole N 55° W 54.26
"X" cut on West end C.M.P. N 30° W 31.30
"X" cut on East end C.M.P. N 50° E 41.47
Re-rod on 1/4 line South 33.00

STATE OF MICHIGAN
GLENN E. RICHARD
No. 13040
PROFESSIONAL SURVEYOR

Ratified by Peer Group in accordance with P.A. 345 Co. Rep. Glenn E. Richard Date 12-18-95

Signed by Glenn E. Richard Date 12-28-95
Glenn E. Richard

Surveyor's Michigan License No. 13040

FORM APPROVED BY MICHIGAN STATE BOARD OF LAND SURVEYORS, JAN. 28, 197

REVISED MAY 14, 1
REVISED JAN., 1
ADAPTED FOR WORD PROCESSING MARCH, 1