

SURVEY & REMONUMENTATION

OCT 19 1998

Filed under Remonumentation Act 345 of 1990

LIBER 1 PAGE 258

LAND CORNER RECORDATION CERTIFICATE

SECTION

Filing Requirement of Act 74, Mich. P.A. 1970

STATE OF MICHIGAN
LENAWEE COUNTY
FILED

15 SEP 1998 9:00:26 AM

VICTORIA J. DANIELS
REGISTER OF DEEDS

Register of Deeds Stamp & File Number

For corners in

<u>Lenawee</u> (County)	Located In:	Corner Code #
1. Public Land Survey	T - 8-S R - 4-E	M-10
	T R	
	T R	
	T R	
2. Property Controlling in Section	S T R	
	S T R	
3. Miscellaneous Property in Sec	S T R	
	S T R	

4. Lot No. _____, Recorded Plat _____
5. Private Claims _____

I, Glenn E. Richard, in a field survey on August 14, 19 98, do hereby certify that under requirements of P.A. 74, Michigan P.A. of 1970, the corner points mentioned in lines 1 and 2 above were in conformance with regulations and rules therefore as required in the current manual of survey instructions of the United States Department of the Interior, Bureau of Land Management or by a decree of a Court of Law and/or that the corner points mentioned in lines 3, 4 and 5 above were in conformance with the rules of the Michigan Board of Land Surveyors or by a Decree of a Court of Law; established, re-established, monumented, re-monumented, recovered, found as expressed below:

NOTE: Not more than 4 corners, all in the same town and range, may be recorded on this certificate.

	A	B	C	D	E	F	G	H	I	J	K	L	M
1													
2	6	5	4	3	2	1							
3													
4	7	8	9	10	11	12							
5													
6	18	17	16	15	14	13							
7													
8	19	20	21	22	23	24							
9													
10	30	29	28	27	26	25							
11													
12	31	32	33	34	35	36							
13													

A. Description of original monument and accessories and/or subsequent restoration:

- GLO 1819 Joseph Wampler Cottonwood 18 stands for 1/ Sec. corner
- 1886 James Blair re-established the corner on a straight line and half way between M-9 and M-11
- 1980 (March) W.E. Frazier & Assoc. "Set iron pipe from record measurement from South according to James Blair, former County Surveyors records dated Feb. 16, 1886. K.L. Suydam recorded it in L 4 P 317
- 1980 (May) I found the iron pipe and recorded it in L 4 P 327
- 1980± Lenawee County Road Commission rebuilt the road and set a monument box

B. Description of corner evidence found and/or method applied in restoring or reestablishing corner:


- June 23, 1998 I found a 3/4" X 12" iron pipe tipped northeast in monument box. Dug in the box and found pieces of tile.
- Aug. 14, 1998 Set a 5/8" X 3' re-rod with a Lenawee County re-mon cap stamped P.S. 13040 at the location of the iron pipe which checked the recorded witnesses.

C. Description of monument for corner and accessories established to perpetuate locating the position of the corner:

5/8" X 3' re-rod with a Lenawee County re-mon cap stamped P.S. 13040 in a monument box and is accepted as the best available evidence of the position of the original corner.

- Fd dbl hd nail & disc in E.P. N 5° E 244.78
- Fd dbl hd nail & disc in E.P. S 15° E 86.89
- NW cor. of house foundation S 20° E 156.22
- Survey mark spike and re-mon tag in 12" Cedar S 20° W 92.21

A-10 T9S R5E South 100.17

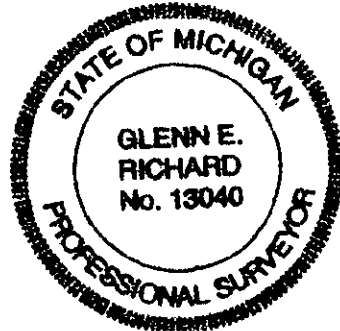

Ratified by Peer Group in accordance with P.A. 345 Co. Rep. Glenn E. Richard Date July 21, 1998

Signed by Glenn E. Richard Date Sept 14, 1998
Glenn E. Richard

Surveyor's Michigan License No. 13040