

OCT 19 1998

LIBER 1 PAGE 267

Filed under Remonumentation Act 345 of 1990

SECTION

LAND CORNER RECORDATION CERTIFICATE
Filing Requirement of Act 74, Mich. P.A. 1970

STATE OF MICHIGAN
LENAWEE COUNTY
FILED

15 SEP 1998 9:03:37 AM

For corners in

<u>Lenawee</u>	Located In:	Corner Code #
(County)		
1. Public Land Survey	T - 8-S R - 5 - E	A-9
	T _____ R _____	_____
	T _____ R _____	_____
	T _____ R _____	_____
2. Property Controlling in Section	S _____ T _____ R _____	_____
	S _____ T _____ R _____	_____
3. Miscellaneous Property in Sec	S _____ T _____ R _____	_____
	S _____ T _____ R _____	_____

VICTORIA J. DANIELS
REGISTER OF DEEDS

Register of Deeds Stamp & File Number

4. Lot No. _____, Recorded Plat _____
5. Private Claims _____

	A	B	C	D	E	F	G	H	I	J	K	L	M
1													
2	6	5	4	3	2	1							
3													
4	7	8	9	10	11	12							
5													
6	18	17	16	15	14	13							
7													
8	19	20	21	22	23	24							
9													
10	30	29	28	27	26	25							
11													
12	31	32	33	34	35	36							
13													

I, Glenn E. Richard, in a field survey on August 14, 19 98, do hereby certify that under requirements of P.A. 74, Michigan P.A. of 1970, the corner points mentioned in lines 1 and 2 above were in conformance with regulations and rules therefore as required in the current manual of survey instructions of the United States Department of the Interior, Bureau of Land Management or by a decree of a Court of Law and/or that the corner points mentioned in lines 3, 4 and 5 above were in conformance with the rules of the Michigan Board of Land Surveyors or by a Decree of a Court of Law; established, re-established, monumented, re-monumented, recovered, found as expressed below:

NOTE: Not more than 4 corners, all in the same town and range, may be recorded on this certificate.

A. Description of original monument and accessories and/or subsequent restoration:

- 1820 Joseph Wampler intersect W. Bdg. 186 links (122.76') S of post Set post at intersection corner Section 19 & 30 Ash 20 S 40 W 3
- 1880 James Blair "Found corner established be G.E. Kendzie
- 1882 James Blair ran line from E 1/4 corner to W 1/4 corner (Type of monumentation not given)
- 1884 James Blair survey calls for "stake & stone"
- 1888 James Blair survey calls for "corner found"
- 1964 Kenneth Suydam re-established the corner (set RR spike) by retracing the deed of the DT & I Railroad Right of Way across the NW 1/4 of Section 30.
- 1975 I found the RR spike and recorded it in L3 P 159
- 1980± Lenawee County Road Commission rebuilt the road and set a monument box.

B. Description of corner evidence found and/or method applied in restoring or reestablishing corner:

June 24, 1998 Found 1/2" re-rod in monument box. I dug 3' South and found a large brown granite stone 3.1 South & 0.3 West of the recorded corner. The peer group approved the location of 3.1 South and on line between M-9 and M-10 T8S R4E. The corner established in 1964 and recorded in L 3 P 159 will be utilized as a property controlling corner for surveys ties to it.


Aug. 14, 1998 I dug out the monument box at the location recorded in L 3 P 159. Left the re-rod of the property controlling. At the approved location, I set a 5/8" X 3' re-rod with a Lenawee County Re-mon cap stamped P.S. 13040 in a monument box

C. Description of monument for corner and accessories established to perpetuate locating the position of the corner:

5/8" X 3' re-rod with Lenawee County Re-mon cap stamped P.S. 13040 in a monument box and is accepted as the best available evidence of the position of the original corner.

- "X" cut on S. end of CMP N 30° W 113.97
- "X" cut on S. end of CMP N 10° W 90.99
- Fd. dbl. hd. nail & disc in E.P. S 70° E 68.64
- NW corner of brick house S 45° E 154.08
- SW corner of brick house S 35° E 212.97

M-9 T8S R4E North 122.86

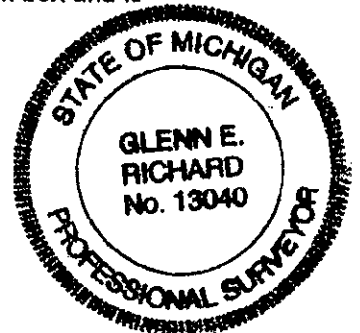

Ratified by Peer Group in accordance with P.A. 345 Co. Rep. Glenn E. Richard Date July 21, 1998

Signed by Glenn E. Richard Date Sept 14, 1998
Glenn E. Richard

Surveyor's Michigan License No. 13040