

SURVEY & REMONUMENTATION

Filed under Remonumentation Act 345 of 1990

MAY 16 1997

LAND CORNER RECORDATION CERTIFICATE

Filing Requirement of Act 74, Mich. P.A. 1970

COMMISSION

LIBER 001 PAGE 125

For corners in

<u>Lenawee</u> (County)	Located In:	Corner Code #
1. Public Land Survey	T <u>8-S</u> R <u>5-E</u>	<u>F-13</u>
	T _____ R _____	_____
	T _____ R _____	_____
	T _____ R _____	_____
2. Property Controlling in Section	S _____ T _____ R _____	_____
	S _____ T _____ R _____	_____
3. Miscellaneous Property in Sec	S _____ T _____ R _____	_____
	S _____ T _____ R _____	_____

STATE OF MICHIGAN
LENAWEE COUNTY
FILED

13 NOV 96 9:05 A.M.

JEANETTE D. KNOX
REGISTER OF DEEDS
Register of Deeds Stamp & File Number

4. Lot No. _____, Recorded Plat _____
5. Private Claims _____

	A	B	C	D	E	F	G	H	I	J	K	L	M
1													
2	6	5	4	3	2	1							
3													
4	7	8	9	10	11	12							
5													
6	18	17	16	15	14	13							
7													
8	19	20	21	22	23	24							
9													
10	30	29	28	27	26	25							
11													
12	31	32	33	34	35	36							
13													

I, Glenn E. Richard, in a field survey on September 5 19 96, do hereby certify that under requirements of P.A. 74, Michigan P.A. of 1970, the corner points mentioned in lines 1 and 2 above were in conformance with regulations and rules therefore as required in the current manual of survey instructions of the United States Department of the Interior, Bureau of Land Management or by a decree of a Court of Law and/or that the corner points mentioned in lines 3, 4 and 5 above were in conformance with the rules of the Michigan Board of Land Surveyors or by a Decree of a Court of Law; established, re-established, monumented, re-monumented, recovered, found as expressed below:

NOTE: Not more than 4 corners, all in the same town and range, may be recorded on this certificate.

A. Description of original monument and accessories and/or subsequent restoration:


GLO
1888 James Blair "found the point of an old stake & set new stake and bricks under stone"
June 1977, K.L. Suydam set a 1" iron rod and recorded it in L. 4, P. 67

B. Description of corner evidence found and/or method applied in restoring or reestablishing corner:

June 10 & 24, 1996, Retraced Blair's survey which resulted in area 2' X 3' for possible location of corner. Dug up entire area and probed farther North but found no evidence of corner described by Blair.
September 5, 1996, Replaced the 1" iron rod with a 3/4" X 3' gas pipe capped G.E.R. P.S. 13040 in monument box.

C. Description of monument for corner and accessories established to perpetuate locating the position of the corner:

3/4" X 3' gas pipe capped G.E.R. P.S. 13040 in monument box and is accepted as the best available evidence of the position of the original corner.
Dbl. hd. nail & remon tag in 36" Maple N 65° W 52.49
Dbl. hd. nail & remon tag in Elec. pole N 15° W 52.72
SW. corner of house foundation N 70° E 242.24
NE. corner of house foundation S 65° W 198.24

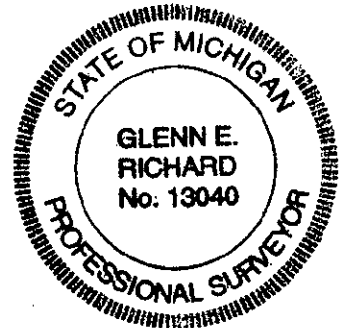

Ratified by Peer Group in accordance with P.A. 345 Co. Rep. Glenn E. Richard Date 8-6-1996

Signed by Glenn E. Richard Date 10-25-96
Glenn E. Richard

Surveyor's Michigan License No. 13040