SURVEY & REMONUMENTATION

NOV 07 1994

COMMISSION

Filed under Remonumentation Act 345 of 1990

LAND CORNER RECORDATION CERTIFICATE

Filing Requirement of Act 74, Mich. P.A. 1970

LIBER 001 PAGE 07

For corners in

Lenawee (County)

	Located In:	Corner Code #
1. Public Land Survey	T-8-S R-5-E	G-1
	T___ R___	
	T___ R___	
	T___ R___	
2. Property Controlling	S___ T___ R___	
in Section	S___ T___ R___	
3. Miscellaneous	S___ T___ R___	
Property in Sec.	S___ T___ R___	

FILED

OCT 10 1994

2:59 P.M.

LENAWEE COUNTY
JEANETTE D. KNOX
REGISTER OF DEEDS

Register of Deeds Stamp & File Number

4. Lot No. _____, Recorded Plat _____
5. Private Claims _____

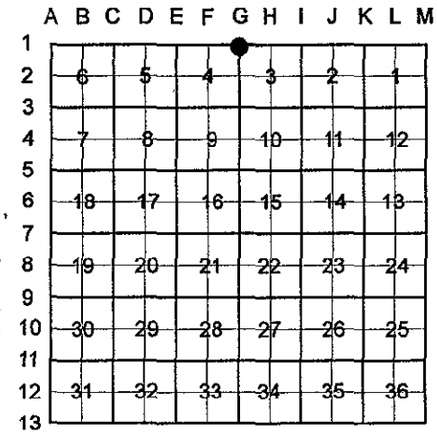

I, Glenn E. Richard, in a field survey on September 19 19 94, do hereby certify that under requirements of P.A. 74, Michigan P.A. of 1970, the corner points mentioned in lines 1 and 2 above were in conformance with regulations and rules therefore as required in the current manual of survey instructions of the United States Department of the Interior, Bureau of Land Management or by a decree of a Court of Law and/or that the corner points mentioned in lines 3, 4 and 5 above were in conformance with the rules of the Michigan Board of Land Surveyors or by a Decree of a Court of Law; established, re-established, monumented, re-monumented, recovered, found as expressed below:

NOTE: Not more than 4 corners, all in the same town and range, may be recorded on this certificate.

A. Description of original monument and accessories and/or subsequent restoration:

G.L.O. 1820 Joseph Wampler set post 100 links East of post to N. Hickory 7 S 2 W 7, Ash 7 N 32 W 11
J.L. Richard records from early 1900's called for iron stake and bricks.
March 1940 Michigan State Highway Dept, boat spike in pave with one of the same witnesses as J.L. Richard records.
1942 Walter Frazier "found corner 4.2 W & 6' N of slab".
October 1977, I found the boat spike and recorded it in L. 4, P. 30.

B. Description of corner evidence found and/or method applied in restoring or reestablishing corner:

Found boat spike 5 inches deep and bricks 2" deeper.

September 19, 1994, replaced boat spike with 3/4" X 3' iron pipe capped P.S. 13040 and monument box.

C. Description of monument for corner and accessories established to perpetuate locating the position of the corner:

3/4" X 3' iron pipe capped P.S. 13040 in monument box and is accepted as the best available evidence of the position of the original corner.
"X" cut in conc headwall N 80° W 16.05
"X" cut in conc headwall S 55° E 38.74
Dbl. hd. nail & disc in Elec. Pole S 30° W 93.20
Dbl. hd. nail & disc in Elec. Pole N 20° W 147.97
SW corner Hse found. N 25° E 92.32
SW corner Sec 34, T7S-R5E West 62.73

STATE OF MICHIGAN
GLENN E. RICHARD
No. 13040
PROFESSIONAL SURVEYOR

Ratified by Peer Group in accordance with P.A. 345 Co. Rep. Glenn E. Richard Date 9-15-94

Signed by Glenn E. Richard Date Oct. 10, 1994
Glenn E. Richard

Surveyor's Michigan License No. 13040

FORM APPROVED BY MICHIGAN STATE BOARD OF LAND SURVEYORS, JAN. 28, 1971

REVISED MAY 14, 1975
REVISED JAN., 1983
ADAPTED FOR WORD PROCESSING MARCH, 1993