

SURVEYOR  
REMONUMENTATION

NOV 07 1994

Filed under Remonumentation Act 345 of 1990  
LAND CORNER RECORDATION CERTIFICATE  
Filing Requirement of Act 74, Mich. P.A. 1970

LIBER 001 PAGE 14

For corners in COMMISSION

<u>Lenawee</u> (County)	Located In:	Corner Code #
1. Public Land Survey	T - <u>8</u> - S R - <u>5</u> - E	<u>G-3</u>
	T _____ R _____	_____
	T _____ R _____	_____
	T _____ R _____	_____
2. Property Controlling in Section	S _____ T _____ R _____	_____
	S _____ T _____ R _____	_____
3. Miscellaneous Property in Sec.	S _____ T _____ R _____	_____
	S _____ T _____ R _____	_____

FILED

2:59 p.m.

OCT 10 1994

LENAWEE COUNTY  
JEANETTE D. KNOX  
REGISTER OF DEEDS

Register of Deeds Stamp & File Number

4. Lot No. \_\_\_\_\_, Recorded Plat \_\_\_\_\_  
5. Private Claims \_\_\_\_\_

I, Glenn E. Richard, in a field survey on JULY 26 19 94,  
do hereby certify that under requirements of P.A. 74, Michigan P.A. of 1970, the corner points mentioned  
in lines 1 and 2 above were in conformance with regulations and rules therefore as required in the  
current manual of survey instructions of the United States Department of the Interior, Bureau of Land  
Management or by a decree of a Court of Law and/or that the corner points mentioned in lines 3, 4 and 5  
above were in conformance with the rules of the Michigan Board of Land Surveyors or by a Decree of a  
Court of Law; established, re-established, monumented, re-monumented, recovered, found as  
expressed below:

A B C D E F G H I J K L M

1													
2	6	5	4	3	2	1							
3													
4	7	8	9	10	11	12							
5													
6	18	17	16	15	14	13							
7													
8	19	20	21	22	23	24							
9													
10	30	29	28	27	26	25							
11													
12	31	32	33	34	35	36							
13													

NOTE: Not more than 4 corners, all in the same town and range, may be recorded on this certificate.

A. Description of original monument and accessories and/or subsequent restoration:


C.L.O. 1820 Joseph Wampler set post corner sections 3, 4, 9 & 10 Lynn 10 West 23 Lynn 8 N 58 E 4  
Survey by James Blair, October 25, 1886 states he found stake and stone 3 1/2' East of bridge (has been replaced with  
CMP)  
July 27, 1950 W.E. Frazier survey "could not find, drove iron at record measure from West and North"  
July 27, 1960 I found the iron pipe and used it on a survey while employed by Mr. Frazier.  
October 14, 1974 found split seam iron pipe set by W.E.F. in monument box and recorded corner in L. 3, P. 49.

B. Description of corner evidence found and/or method applied in restoring or reestablishing corner:

Found split seam iron pipe in monument box.  
July 26, 1994, Replaced split seam iron with 3/4" X 3' iron pipe and raised monument box to surface of the pavement.

C. Description of monument for corner and accessories established to perpetuate locating the position of the corner:

3/4" X 3' iron pipe, capped GER P.S. 13040, in monument box and is accepted as the best available evidence of the  
position of the original corner.  
"X" cut on CMP N 45° W 30.73  
"X" cut on CMP S 45° W 29.46  
SW corner of Brick house N 55° E 115.87  
NW corner of Brick house N 35° E 156.37  
SE corner Conc blk garage N 70° E 195.56

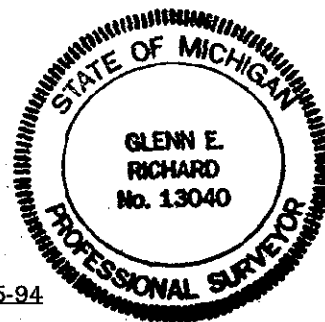

Ratified by Peer Group in accordance with P.A. 345 Co. Rep. Glenn E. Richard Date 9-15-94  
Signed by Glenn E. Richard Date OCT 10, 1994  
Glenn E. Richard

Surveyor's Michigan License No. 13040