

NOV 07 1994

Filed under Remonumentation Act 345 of 1990

LAND CORNER RECORDATION CERTIFICATE

Filing Requirement of Act 74, Mich. P.A. 1970

LIBER 001 PAGE 15

For corners in

Lenawee Located In: Corner Code #

- 1. Public Land Survey T-8-S R-5-E G-4
2. Property Controlling in Section S T R
3. Miscellaneous Property in Sec. S T R

FILED OCT 10 1994 2:59 P.M. LENAWEE COUNTY JEANETTE D. KNOX REGISTER OF DEEDS Register of Deeds Stamp & File Number

- 4. Lot No. Recorded Plat
5. Private Claims

I, Glenn E. Richard, in a field survey on July 26 19 94, do hereby certify that under requirements of P.A. 74, Michigan P.A. of 1970, the corner points mentioned in lines 1 and 2 above were in conformance with regulations and rules therefore as required in the current manual of survey instructions of the United States Department of the Interior, Bureau of Land Management or by a decree of a Court of Law and/or that the corner points mentioned in lines 3, 4 and 5 above were in conformance with the rules of the Michigan Board of Land Surveyors or by a Decree of a Court of Law; established, re-established, monumented, re-monumented, recovered, found as expressed below:

Grid table with columns A-M and rows 1-13. Cell (4,9) contains a black dot.

NOTE: Not more than 4 corners, all in the same town and range, may be recorded on this certificate.

A. Description of original monument and accessories and/or subsequent restoration:


G.L.O. 1820 Joseph Wampler set 1/4 post Elm 6 N 64 W 7 Ash 5 S 44 E 3 December 1881 James Blair re-established the corner by setting stake half way between NE & SE section corner November 17, 1975, Dug through the pavement and found wood stake, tile and piece of gas pipe and raised to surface with 3/4" X 2' iron pipe and recorded in L. 3, P. 338.

B. Description of corner evidence found and/or method applied in restoring or reestablishing corner:

June 9, 1993, Found 3/4" iron pipe which checked remaining witnesses. Set 1/2" rebar on 1/4 line 72.74 West of the 1/4 corner Set 1/2" rebar on 1/4 line 163.31 West on the 1/4 corner to hold location during road construction. July 26, 1994, Set 3/4" X 3' iron pipe capped G.E.R. P.S. 13040, and set monument box

C. Description of monument for corner and accessories established to perpetuate locating the position of the corner:

3/4" X 3' iron pipe, capped G.E.R. P.S. 13040, in monument box and is accepted as the best available evidence of the position of the original corner. 1/2" rebar on 1/4 line West 72.74 1/2" rebar on 1/4 line West 163.31 West 1/4 corner West 5250.86 NW corner Conc hdwl S 50° W 22.16 SW corner Conc hdwl N 50° W 22.74

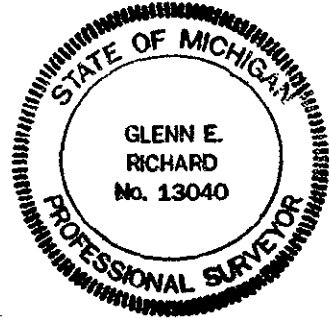

Ratified by Peer Group in accordance with P.A. 345 Co. Rep. Glenn E. Richard Date 9-15-94 Signed by Glenn E. Richard Date Oct 10, 1994 Glenn E. Richard

Surveyor's Michigan License No. 13040