

NOV 07 1994

COMMISSION

Filed under Remonumentation Act 345 of 1990
LAND CORNER RECORDATION CERTIFICATE
Filing Requirement of Act 74, Mich. P.A. 1970

LIBER 001 PAGE 18

For corners in
Lenawee Located In: Corner Code #
(County)

1. Public Land Survey T-8-S R-5-E G-7
T R
T R
T R

2. Property Controlling S T R
in Section S T R
3. Miscellaneous S T R
Property in Sec. S T R

FILED 2:59 P.M.
OCT 10 1994
LENAWEE COUNTY
JEANETTE D. NOX
REGISTER OF DEEDS
Register of Deeds Stamp & File Number

4. Lot No. _____ Recorded Plat _____
5. Private Claims _____

	A	B	C	D	E	F	G	H	I	J	K	L	M
1													
2	6	5	4	3	2	1							
3													
4	7	8	9	10	11	12							
5													
6	18	17	16	15	14	13							
7													
8	19	20	21	22	23	24							
9													
10	30	29	28	27	26	25							
11													
12	31	32	33	34	35	36							
13													


I, Glenn E. Richard, in a field survey on August 12 19 94, do hereby certify that under requirements of P.A. 74, Michigan P.A. of 1970, the corner points mentioned in lines 1 and 2 above were in conformance with regulations and rules therefore as required in the current manual of survey instructions of the United States Department of the Interior, Bureau of Land Management or by a decree of a Court of Law and/or that the corner points mentioned in lines 3, 4 and 5 above were in conformance with the rules of the Michigan Board of Land Surveyors or by a Decree of a Court of Law; established, re-established, monumented, re-monumented, recovered, found as expressed below:

NOTE: Not more than 4 corners, all in the same town and range, may be recorded on this certificate.

A. Description of original monument and accessories and/or subsequent restoration:
G.L.O. 1820 Joseph Wampler set post corner sections 15, 16, 21 & 22 hickory 6 West 4 Ash 9 N 15° W 19 Survey by GE Kedzie, Co., Surveyor on April 6, 1877 called for stone June 1881, James Blair, called for stone & again on survey in 1883. Survey records of J.L. Richard. One set of notes called for stone and another called for stake. May 7, 1971, Dug large hole but didn't find the corner. Set 3/4" X 4' iron pipe at record distance from South (Blair) and Road survey from the West which checked Blair's record angle at the Northeast corner of Section 21 and recorded corner in L. 1, P. 159 and L. 1, P. 409.

B. Description of corner evidence found and/or method applied in restoring or reestablishing corner:
June 7, 1993 Found 3/4" iron pipe.
August 12, 1994, Replaced it with 3/4" X 3' iron pipe and set monument box.

C. Description of monument for corner and accessories established to perpetuate locating the position of the corner:
3/4" X 3' iron pipe, capped G.E.R. P.S. 13040, in monument box and is accepted as the best available evidence of the position of the original corner.
Dbl. hd. nail & disc in Elec pole S 65° W 51.29 P.K. nail in pave on Section line West 138.20
Fd. P.K. in face of Elec Pole S 70° E 60.44
"X" cut on top S. end of 36" C.M.P. S 25° W 32.27
"X" cut on top N. end of 36" C.M.P. N 30° W 36.24
SE corner Conc hdwl S 85° W 291.93

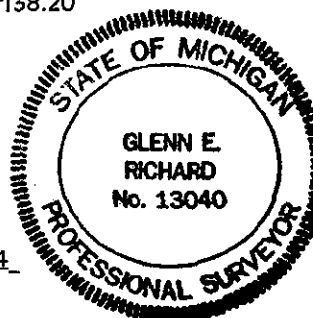

Ratified by Peer Group in accordance with P.A. 345 Co. Rep. Glenn E. Richard Date 9-15-94
Signed by Glenn E. Richard Date Oct 10, 1994
Surveyor's Michigan License No. 13040