

SURVEY & REMONUMENTATION

Filed under Remonumentation Act 345 of 1990

LAND CORNER RECORDATION CERTIFICATE

Filing Requirement of Act 74, Mich. P.A. 1970

NOV 07 1994

LIBER 001 PAGE 19

COMMISSION

For corners in

Lenawee

(County)

Located In:

Corner Code #

- | | | |
|------------------------------------|---------------------------|------------|
| 1. Public Land Survey | T <u>8</u> S R <u>5</u> E | <u>G-8</u> |
| | T _____ R _____ | _____ |
| | T _____ R _____ | _____ |
| | T _____ R _____ | _____ |
| 2. Property Controlling in Section | S _____ T _____ R _____ | _____ |
| | S _____ T _____ R _____ | _____ |
| 3. Miscellaneous Property in Sec. | S _____ T _____ R _____ | _____ |
| | S _____ T _____ R _____ | _____ |

FILED

2:59 P.M.

OCT 10 1994

LENAWEE COUNTY
JEANETTE D. F. NOX
REGISTER OF DEEDS

Register of Deeds Stamp & File Number

4. Lot No. _____, Recorded Plat _____
5. Private Claims _____

A B C D E F G H I J K L M

1														
2	6	5	4	3	2	1								
3														
4	7	8	9	10	11	12								
5														
6	18	17	16	15	14	13								
7														
8	19	20	21	22	23	24								
9														
10	30	29	28	27	26	25								
11														
12	31	32	33	34	35	36								
13														

I, Glenn E. Richard, in a field survey on August 16 1994, do hereby certify that under requirements of P.A. 74, Michigan P.A. of 1970, the corner points mentioned in lines 1 and 2 above were in conformance with regulations and rules therefore as required in the current manual of survey instructions of the United States Department of the Interior, Bureau of Land Management or by a decree of a Court of Law and/or that the corner points mentioned in lines 3, 4 and 5 above were in conformance with the rules of the Michigan Board of Land Surveyors or by a Decree of a Court of Law; established, re-established, monumented, re-monumented, recovered, found as expressed below:

NOTE: Not more than 4 corners, all in the same town and range, may be recorded on this certificate.

A. Description of original monument and accessories and/or subsequent restoration:


G.L.O. 1820 Joseph Wampler set 1/4 post Sugar 9 N 56 W 28 Beech 20 S 20 E 5 June 1881, Survey by James Blair called for iron and he found it again in June 1883. May 7, 1971 We dug and found iron bar under pieces of sand stone 3' deep, raised to surface with 3/4" iron pipe and recorded corner in L. 1, P. 151 and L. 1, P. 407.

B. Description of corner evidence found and/or method applied in restoring or reestablishing corner:

June 7, 1993, Found 3/4" iron pipe.
August 16, 1994, Replaced it with 3/4" X 3' iron pipe and set monument box.

C. Description of monument for corner and accessories established to perpetuate locating the position of the corner:

3/4" X 3' iron pipe, capped G.E.R. P.S. 13040, in monument box and is accepted as the best available evidence of the position of the original corner.
Dbl. hd. nail & disc in 12" Apple N 85° W 193.09 Dbl. hd. nail & disc in Elec pole S 50° E 44.53
Dbl. hd. nail & disc in Elec Pole S 50° E 44.56
P.K. Nail in pavement on 1/4 line East 122.66
P.K. Nail in pavement on 1/4 line East 501.92
NE corner Brick hse N 45° W 172.72
SW corner fireplace N 60° W 187.40

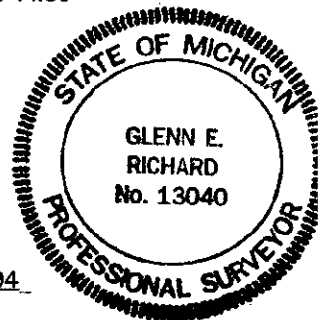

Ratified by Peer Group in accordance with P.A. 345

Signed by Glenn E. Richard
Glenn E. Richard

Co. Rep. Glenn E. Richard

Date Oct. 10, 1994

Date 9-15-94

Surveyor's Michigan License No. 13040