

**SURVEY &  
REMONUMENTATION**

Filed under Remonumentation Act 345 of 1990

SEP 03 1996

LAND CORNER RECORDATION CERTIFICATE

COMMISSION

Filing Requirement of Act 74, Mich. P.A. 1970

LIBER 001 PAGE 110

For corners in

<u>Lenawee</u> (County)	Located In:	Corner Code #
1. Public Land Survey	T-8-S R-5-E	G-12
	T_____ R_____	_____
	T_____ R_____	_____
	T_____ R_____	_____
2. Property Controlling in Section	S_____ T_____ R_____	_____
	S_____ T_____ R_____	_____
3. Miscellaneous Property in Sec	S_____ T_____ R_____	_____
	S_____ T_____ R_____	_____

**FILED**  
AUG 08 1996  
12:57 P.M.  
LENAWEE COUNTY  
JEANETTE D. KNOX  
REGISTER OF DEEDS  
Register of Deeds Stamp & File Number

4. Lot No. \_\_\_\_\_, Recorded Plat \_\_\_\_\_  
5. Private Claims \_\_\_\_\_

	A	B	C	D	E	F	G	H	I	J	K	L	M
1													
2	6	5	4	3	2	1							
3													
4	7	8	9	10	11	12							
5													
6	18	17	16	15	14	13							
7													
8	19	20	21	22	23	24							
9													
10	30	29	28	27	26	25							
11													
12	31	32	33	34	35	36							
13													

I, Glenn E. Richard, in a field survey on June 10 1996, do hereby certify that under requirements of P.A. 74, Michigan P.A. of 1970, the corner points mentioned in lines 1 and 2 above were in conformance with regulations and rules therefore as required in the current manual of survey instructions of the United States Department of the Interior, Bureau of Land Management or by a decree of a Court of Law and/or that the corner points mentioned in lines 3, 4 and 5 above were in conformance with the rules of the Michigan Board of Land Surveyors or by a Decree of a Court of Law; established, re-established, monumented, re-monumented, recovered, found as expressed below:

**NOTE: Not more than 4 corners, all in the same town and range, may be recorded on this certificate.**

A. Description of original monument and accessories and/or subsequent restoration:


1820 Joseph Wampler set 1/4 Section post R. Oak 18 N 46 W 5 Ash 14 S 74 E 10  
1888 & 1891 James Blair found stone  
April 1973 Dug and found 3 large stones. Set 3/4" X 4' iron pipe for the corner which checked Blairs angle at the Northeast corner of Section 33 and the distance south from the Northeast corner of Section 33. Recorded it in Liber 2, Page 339

B. Description of corner evidence found and/or method applied in restoring or reestablishing corner:

June 10, 1996 The road is under re-construction. Dug and found bottom of iron set in 1973.  
Set 3/4" X 3' gas pipe capped G.E.R. 13040 on top and drove both of them down.  
June 26, 1996 Set monument box in new asphalt pave

C. Description of monument for corner and accessories established to perpetuate locating the position of the corner:

3/4" X 3' gas pipe capped G.E.R. 13040 in monument box and is accepted as the best available evidence of the position of the original corner.  
"X" cut on S. end C.M.P. West 23.72  
"X" cut on N. end C.M.P. N 30 W 50.18  
dbl. hd. nail & Re-mon tag in post East 31.17  
dbl. hd. nail & Re-mon tag in post West 34.13  
N.E. corner Section 33 N. 2677.83 (Blair rec. = 2678.28)  
S.E. corner Section 33 S. 2694.50 (Blair rec. = 2693.13)

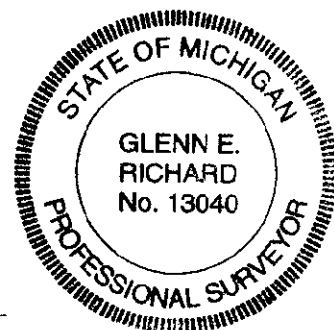

Ratified by Peer Group in accordance with P.A. 345 Co. Rep. Glenn E. Richard Date 7-16-96

Signed by Glenn E. Richard Date 7-29-96  
Glenn E. Richard

Surveyor's Michigan License No. 13040