

SURVEY & REMONUMENTATION

NOV 07 1994

Filed under Remonumentation Act 345 of 1990

COMMISSION

LAND CORNER RECORDATION CERTIFICATE

Filing Requirement of Act 74, Mich. P.A. 1970

LIBER 001 PAGE 08

For corners in

<u>Lenawee</u>	Located In:	Corner Code #
(County)		
1. Public Land Survey	T <u>8-S</u> R <u>5-E</u>	<u>H-1</u>
	T _____ R _____	_____
	T _____ R _____	_____
	T _____ R _____	_____
2. Property Controlling in Section	S _____ T _____ R _____	_____
	S _____ T _____ R _____	_____
3. Miscellaneous Property in Sec.	S _____ T _____ R _____	_____
	S _____ T _____ R _____	_____

FILED

OCT 10 1994

2:59 P.M.

LENAWEE COUNTY
JEANETTE D. NOX
REGISTER OF DEEDS

Register of Deeds Stamp & File Number

4. Lot No. _____, Recorded Plat _____
5. Private Claims _____

	A	B	C	D	E	F	G	H	I	J	K	L	M
1								●					
2	6	5	4	3	2	1							
3													
4	7	8	9	10	11	12							
5													
6	18	17	16	15	14	13							
7													
8	19	20	21	22	23	24							
9													
10	30	29	28	27	26	25							
11													
12	31	32	33	34	35	36							
13													

I, Glenn E. Richard, in a field survey on September 19 1994, do hereby certify that under requirements of P.A. 74, Michigan P.A. of 1970, the corner points mentioned in lines 1 and 2 above were in conformance with regulations and rules therefore as required in the current manual of survey instructions of the United States Department of the Interior, Bureau of Land Management or by a decree of a Court of Law and/or that the corner points mentioned in lines 3, 4 and 5 above were in conformance with the rules of the Michigan Board of Land Surveyors or by a Decree of a Court of Law; established, re-established, monumented, re-monumented, recovered, found as expressed below:

NOTE: Not more than 4 corners, all in the same town and range, may be recorded on this certificate.

A. Description of original monument and accessories and/or subsequent restoration:

Corner not set on original government survey
October 23, 1886, James Blair "found old stake and set a stone".
1934 Walter Frazier found the stone and an iron over same.
March 1940, M.S.H.D. called for 1/2" bar, stones and tile.
March 1958, I found an iron rod and tile during a survey of Stadler Road.
August 1982, I found the iron rod and recorded it in L. 5, P. 53.

B. Description of corner evidence found and/or method applied in restoring or reestablishing corner:


Found iron rod as per L.C.R.C. L. 5, P. 53

September 19, 1994, replaced iron rod with 3/4" X 3" iron pipe in monument box (hit stone with 3/4" iron pipe and it bent bottom to the west).

C. Description of monument for corner and accessories established to perpetuate locating the position of the corner:

3/4" X 3" iron pipe capped P.S. 13040 in monument box. This position not established by original government surveyors. This monument is accepted as the best available evidence of the position of the corner.

- "X" cut on C.M.P. S 40° W 33.67
- "X" cut on C.M.P. S 75° W 82.51
- "X" cut on C.M.P. N 70° W 84.95
- "X" cut on C.M.P. N 45° W 40.17
- S 1/4 corner Section 34, T7S-R5E, West 61.75

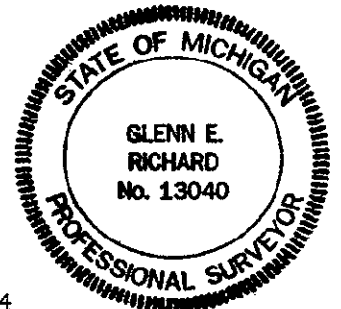

Ratified by Peer Group in accordance with P.A. 345 Co. Rep. Glenn E. Richard Date 9-15-94

Signed by Glenn E. Richard Date Oct 10, 1994

Glenn E. Richard

Surveyor's Michigan License No. 13040