

JAN 26 2000

Filed under Remonumentation Act 345 of 1990

LAND CORNER RECORDATION CERTIFICATE

LIBER 1 PAGE 339

Filing Requirement of Act 74, Mich. P.A. 1970

STATE OF MICHIGAN  
LENAWEE COUNTY  
FILED

SECTION

For corners in

Lenawee

(County)

Located In:

Corner Code #

29 SEP 1999 5:34:06 PM

JUDITH J. DANIELS  
REGISTER OF DEEDS

Register of Deeds Stamp & File Number

1. Public Land Survey	T - 8 - S	R - 5 - E	H-2
	T	R	
	T	R	
	T	R	
2. Property Controlling in Section	S	T	R
	S	T	R
3. Miscellaneous Property in Sec	S	T	R
	S	T	R

4. Lot No. \_\_\_\_\_, Recorded Plat \_\_\_\_\_  
5. Private Claims \_\_\_\_\_

I, Glenn E. Richard, in a field survey on September 13, 19 99, do hereby certify that under requirements of P.A. 74, Michigan P.A. of 1970, the corner points mentioned in lines 1 and 2 above were in conformance with regulations and rules therefore as required in the current manual of survey instructions of the United States Department of the Interior, Bureau of Land Management or by a decree of a Court of Law and/or that the corner points mentioned in lines 3, 4 and 5 above were in conformance with the rules of the Michigan Board of Land Surveyors or by a Decree of a Court of Law; established, re-established, monumented, re-monumented, recovered, found as expressed below:

	A	B	C	D	E	F	G	H	I	J	K	L	M
1													
2	6	5	4	3	2	1							
3													
4	7	8	9	10	11	12							
5													
6	18	17	16	15	14	13							
7													
8	19	20	21	22	23	24							
9													
10	30	29	28	27	26	25							
11													
12	31	32	33	34	35	36							
13													


NOTE: Not more than 4 corners, all in the same town and range, may be recorded on this certificate.

A. Description of original monument and accessories and/or subsequent restoration:

This position not established by original government surveyors  
1886 James Blair found old stake and set stone over it.  
1926 J.L. Richard found stone & cut "X" on top.  
1934 Walter Frazier found stone with "X" cut on top.  
1972 I found stone with "X" cut on top and recorded it in Liber 1 Page 341

B. Description of corner evidence found and/or method applied in restoring or reestablishing corner:

Sept. 13, 1999 I found stone with "X" cut on top 19" deep. Drilled through the stone and set 5/8" X 3' re-rod with Lenawee County re-mon cap stamped P.S. 13040

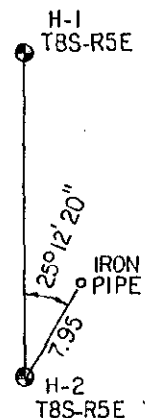

C. Description of monument for corner and accessories established to perpetuate locating the position of the corner:

5/8" X 3' re-rod through the stone with Lenawee County Re-mon cap stamped P.S. 13040. This position not established by original government surveyors. This monument is accepted as the best available evidence of the position of the corner.

Fd. dbl. hd. nail & disc in E.P. N 30° W 56.89  
Fd. dbl. hd. nail & disc in E.P. S 85° E 37.37  
NW corner of concrete house foundation S 60° E 69.81  
Cut "X" on CMP S 50° W 30.25



Ratified by Peer Group in accordance with P.A. 345 Co. Rep. Glenn E. Richard Date September 14, 1999

Signed by Glenn E. Richard Date Sept. 23, 1999  
Glenn E. Richard

Surveyor's Michigan License No. 13040