

JAN 25 2000

Filed under Remonumentation Act 345 of 1990
LAND CORNER RECORDATION CERTIFICATE LIBER 1
Filing Requirement of Act 74, Mich. P.A. 1970

PAGE 358
STATE OF MICHIGAN
LENAWEE COUNTY
FILED

SECTION

For corners in
Lenawee
(County)

Located In:

Corner Code #

15 NOV 1999 9:55:37 AM

VICTORIA J. DANIELS
REGISTER OF DEEDS

1. Public Land Survey	T - 8 - S	R - 5 - E	K-3
	T	R	
	T	R	
	T	R	
2. Property Controlling in Section	S	T	R
	S	T	R
3. Miscellaneous Property in Sec	S	T	R
	S	T	R

Register of Deeds Stamp & File Number

4. Lot No. _____, Recorded Plat _____
5. Private Claims _____

I, Glenn E. Richard, in a field survey on October 5, 19 99, do hereby certify that under requirements of P.A. 74, Michigan P.A. of 1970, the corner points mentioned in lines 1 and 2 above were in conformance with regulations and rules therefore as required in the current manual of survey instructions of the United States Department of the Interior, Bureau of Land Management or by a decree of a Court of Law and/or that the corner points mentioned in lines 3, 4 and 5 above were in conformance with the rules of the Michigan Board of Land Surveyors or by a Decree of a Court of Law, established, re-established, monumented, re-monumented, recovered, found as expressed below:

NOTE: Not more than 4 corners, all in the same town and range, may be recorded on this certificate.

A	B	C	D	E	F	G	H	I	J	K	L	M
1												
2	6	5	4	3	2							
3												
4	7	8	9	10	11	12						
5												
6	18	17	16	15	14	13						
7												
8	19	20	21	22	23	24						
9												
10	30	29	28	27	26	25						
11												
12	31	32	33	34	35	36						
13												

A. Description of original monument and accessories and/or subsequent restoration:

- GLO 1820 Joseph Wampler set post cor. Sec.'s 1, 2, 11 & 12 Sugar 18 North 16 W. Oak 11 S 45 E 18
- 1870 Burton Kent found corner from witness tree or stumps
- 1879 G.E. Kedzie found Section corner post standing
- 1881 James Blair found stake. Placed stones around stake bringing the points together over top of stake.
- 1885 James Blair surveyed sections 1 and 12 and called for stake between two stones
- 1886 James Blair surveyed Section 2 and called for stake between two stones
- 1890 James Blair did survey in Section 12 and called for stake between two stones
- 1929 Walter Frazier found stones & iron SE corner of school house N 33° 30' W 110.5,
- 10" Maple N 65 W 99.85 6" Maple N 42° 15' W 55.0
- 1964 I dug and found stone which checked the 1929 witnesses. I raised with 1/2 iron bar
- 1971 I found 1/2" iron bar and recorded it in Liber 1, Page 11
- 1974 Kenneth Suydam found iron


B. Description of corner evidence found and/or method applied in restoring or reestablishing corner:

Oct. 5, 1999 Found 1" X 24" iron pipe over 3/4" iron bar between stones on the North and South sides under monument box. Replaced the found irons with 5/8" X 3' re-rod with Lenawee County Re-mon cap stamped P.S. 13040

C. Description of monument for corner and accessories established to perpetuate locating the position of the corner:

5/8" X 3' re-rod with Lenawee County Re-mon cap stamped P.S. 13040 in a monument box and is accepted as a careful and faithful perpetuation of the position of the original corner.

- Original corner of school hse N 35° W 110.23
- New corner of school hse N 40° W 99.14
- 20" Maple N 45° W 54.2
- 26" Maple N 70° W 99.0
- Fd. "X" cut on N. end CMP N 45° W 29.02
- Fd. "X" cut on S. end CMP S 50° W 25.04
- Fd. dbl hd. nail & disc in brace pole S 40° E 44.40
- Fd. dbl. hd. nail & disc in E.P. added Lenawee County Re-mon tag N 52° E 35.49
- The corner is 8' west of North-South centerline and 3' south of East-West centerline

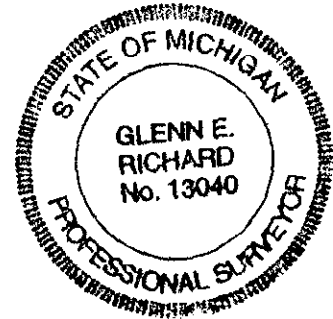

Ratified by Peer Group in accordance with P.A. 345 Co. Rep. Glenn E. Richard Date October 26, 1999

Signed by Glenn E. Richard Date Oct. 29, 1999
Glenn E. Richard

Surveyor's Michigan License No. 13040