SURVEY & REMONUMENTATION

NOV 07 1994

COMMISSION

Filed under Remonumentation Act 345 of 1990

LAND CORNER RECORDATION CERTIFICATE

Filing Requirement of Act 74, Mich. P.A. 1970

LIBER 001 PAGE 13

FILED 2:59 P.M.

OCT 10 1994

LENAWEE COUNTY
JEANETTE D. KNOX
REGISTER OF DEEDS

Register of Deeds Stamp & File Number

For corners in

Lenawee (County)

		Located In:	Corner Code #
1. Public Land Survey		T-8-S R-5-E	L-1
		T___ R___	
		T___ R___	
		T___ R___	
2. Property Controlling	S___	T___ R___	
in Section	S___	T___ R___	
3. Miscellaneous	S___	T___ R___	
Property in Sec.	S___	T___ R___	

4. Lot No. _____, Recorded Plat _____
5. Private Claims _____

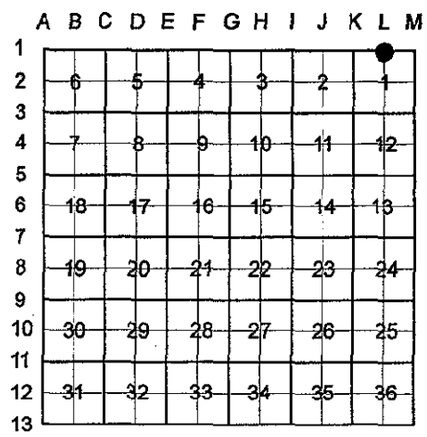

I, Glenn E. Richard, in a field survey on Sept. 30 19 94, do hereby certify that under requirements of P.A. 74, Michigan P.A. of 1970, the corner points mentioned in lines 1 and 2 above were in conformance with regulations and rules therefore as required in the current manual of survey instructions of the United States Department of the Interior, Bureau of Land Management or by a decree of a Court of Law and/or that the corner points mentioned in lines 3, 4 and 5 above were in conformance with the rules of the Michigan Board of Land Surveyors or by a Decree of a Court of Law; *established, re-established, monumented, re-monumented, recovered, found* as expressed below:

NOTE: Not more than 4 corners, all in the same town and range, may be recorded on this certificate.

A. Description of original monument and accessories and/or subsequent restoration:

G.L.O. not set on government survey.
November 1985, James Blair established the corner with a stake midway between the NW and NE cor of Section 1
Early 1900's, J.L. Richard records called for stone 3 1/4' long.
May 1972, We dug and found stone 3' long to verify stone found at the S 1/4 corner, Section 36, T7S-R5E, and set iron pipe with top over the stone.

B. Description of corner evidence found and/or method applied in restoring or reestablishing corner:

September 25, 1994, found iron pipe 0.76 North of line between S 1/4 corner and SE corner of Section 36, T7S-R5E
September 30, 1994, set 3/4" X 3' iron pipe capped P.S. 13040 in monument box 0.76 South of found iron pipe to be on south line of Section 36, T7S-R5E.

C. Description of monument for corner and accessories established to perpetuate locating the position of the corner:

3/4" X 3' iron pipe capped P.S. 13040 in monument box. This position not established by original government surveyors. This monument is accepted as the best available evidence of the position of the corner.

Nail & disc in Elec Pole S 75° E 137.88
Dbl. hd. nail & disc in Elec Pole S 80° W 221.83
Dbl. hd. nail & disc in buried cable post N 40° W 25.66
Dbl. hd. nail & disc in Elec Pole N 80° E 157.21
SW corner house found. N 70° E 194.53
S 1/4 corner, Section 36, T7S-R5E, West 38.01

STATE OF MICHIGAN
GLENN E. RICHARD
No. 13040
PROFESSIONAL SURVEYOR

Ratified by Peer Group in accordance with P.A. 345 Co. Rep. Glenn E. Richard Date 9-15-94

Signed by Glenn E. Richard Date October 3, 1994

Glenn E. Richard

Surveyor's Michigan License No. 13040

FORM APPROVED BY MICHIGAN STATE BOARD OF LAND SURVEYORS, JAN. 28, 1971

REVISED MAY 14, 1975
REVISED JAN., 1983
ADAPTED FOR WORD PROCESSING MARCH, 1993