

JAN 4 2000

Filed under Remonumentation Act 345 of 1990

LAND CORNER RECORDATION CERTIFICATE

Filing Requirement of Act 74, Mich. P.A. 1970 LIBER 1

PAGE 368  
STATE OF MICHIGAN  
LENAWEE COUNTY  
FILED

SECTION

For corners in

Located In:

Corner Code #

Lenawee  
(County)

- 1. Public Land Survey      T - 8 - S   R - 5 - E      M-11
- T            R
- T            R
- T            R
- T            R
- 2. Property Controlling    S            T            R
- In Section                S            T            R
- 3. Miscellaneous            S            T            R
- Property in Sec         S            T            R

15 NOV 1999 9:58:24 AM

VICTORIA J. DANIELS  
REGISTER OF DEEDS

Register of Deeds Stamp & File Number

- 4. Lot No. \_\_\_\_\_ Recorded Plat \_\_\_\_\_
- 5. Private Claims \_\_\_\_\_

I, Glenn E. Richard, in a field survey on October 1, 19 99, do hereby certify that under requirements of P.A. 74, Michigan P.A. of 1970, the corner points mentioned in lines 1 and 2 above were in conformance with regulations and rules therefore as required in the current manual of survey instructions of the United States Department of the Interior, Bureau of Land Management or by a decree of a Court of Law and/or that the corner points mentioned in lines 3, 4 and 5 above were in conformance with the rules of the Michigan Board of Land Surveyors or by a Decree of a Court of Law, established, re-established, monumented, re-monumented, recovered, found as expressed below:

	A	B	C	D	E	F	G	H	I	J	K	L	M
1													
2	6	5	4	3	2	1							
3													
4	7	8	9	10	11	12							
5													
6	18	17	16	15	14	13							
7													
8	19	20	21	22	23	24							
9													
10	30	29	28	27	26	25							
11													
12	31	32	33	34	35	36							
13													

NOTE: Not more than 4 corners, all in the same town and range, may be recorded on this certificate.

A. Description of original monument and accessories and/or subsequent restoration:

- GLO 1820 Joseph Wampler set post cor. Sec.'s 25 & 36 Sugar 11 S 24 W 11 Beech 14 N 14 E 9
- 1895 James Blair described the corner as Iron & Stones
- 1970 I dug and found iron bar, sand stone, stones & brick and raised with 1/2" iron pipe
- 1972 Werner Sommer found 1/2" iron pipe and recorded it in Liber 1, Page 627


B. Description of corner evidence found and/or method applied in restoring or reestablishing corner:

Oct. 1, 1999 Found 1/2" X 38" iron pipe at the surface which checked the remaining witnesses. Found iron bar and pieces of sand stone 19" deep 0.04 north of the 1/2" iron pipe. Replaced the iron bar with a 5/8" X 3' re-rod with a Lenawee County Re-mon cap stamped P.S. 13040 and set a monument box.

C. Description of monument for corner and accessories established to perpetuate locating the position of the corner:

5/8" X 3' re-rod with Lenawee County Re-mon cap stamped P.S. 13040 in a monument box and is accepted as the best available evidence of the position of the original corner.

- Fd. dbl. hd. nail & disc in E.P. S 45° W 40.17
- Fd. dbl. hd. nail & disc in T.P. added Lenawee County re-mon tag N 70° W 65.78
- Cut "X" on C.M.P. N 40° W 30.76
- Most westerly corner of block wall on porch steps East 55.13
- Monroe County brass re-mon cap in monument box at A-11 T8S-R6E South 82.93

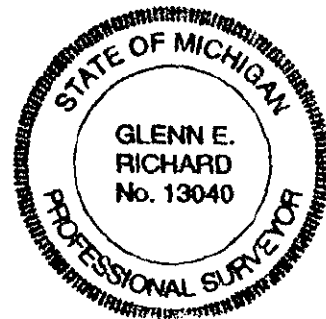

Ratified by Peer Group in accordance with P.A. 345 Co. Rep. Glenn E. Richard Date October 26, 1999

Signed by Glenn E. Richard Date Oct. 29, 1999  
Glenn E. Richard

Surveyor's Michigan License No. 13040