

**SURVEY & REMONUMENTATION**

**JAN 15 1998**

**SECTION**

Filed under Remonumentation Act 345 of 1990

**LAND CORNER RECORDATION CERTIFICATE** LIBER 1 PAGE 204

Filing Requirement of Act 74, Mich. P.A. 1970

For corners in

Lenawee  
(County)

Located In:

Corner Code #

STATE OF MICHIGAN  
LENAWEE COUNTY  
FILED

17 OCT 97 3:52 P.M.

VICTORIA J. DANIELS  
REGISTER OF DEEDS

Register of Deeds Stamp & File Number

- |                                    |   |     |   |     |     |
|------------------------------------|---|-----|---|-----|-----|
| 1. Public Land Survey              | T | 9-S | R | 1-E | G-2 |
|                                    | T |     | R |     |     |
|                                    | T |     | R |     |     |
|                                    | T |     | R |     |     |
| 2. Property Controlling in Section | S | T   | R |     |     |
|                                    | S | T   | R |     |     |
| 3. Miscellaneous Property in Sec   | S | T   | R |     |     |
|                                    | S | T   | R |     |     |

4. Lot No. \_\_\_\_\_, Recorded Plat \_\_\_\_\_  
5. Private Claims \_\_\_\_\_

I, Glenn E. Richard, in a field survey on Sept. 3, 1997, do hereby certify that under requirements of P.A. 74, Michigan P.A. of 1970, the corner points mentioned in lines 1 and 2 above were in conformance with regulations and rules therefore as required in the current manual of survey instructions of the United States Department of the Interior, Bureau of Land Management or by a decree of a Court of Law and/or that the corner points mentioned in lines 3, 4 and 5 above were in conformance with the rules of the Michigan Board of Land Surveyors or by a Decree of a Court of Law, established, re-established, monumented, re-monumented, recovered, found as expressed below:

	A	B	C	D	E	F	G	H	I	J	K	L	M
1													
2	6	5	4	●	3	2	1						
3													
4	7	8	9	10	11	12							
5													
6	18	17	16	15	14	13							
7													
8	19	20	21	22	23	24							
9													
10	30	29	28	27	26	25							
11													
12	31	32	33	34	35	36							
13													


NOTE: Not more than 4 corners, all in the same town and range, may be recorded on this certificate.

A. Description of original monument and accessories and/or subsequent restoration:

G.L.O. Ziba Swan 1824 set 1/4 Sec. post Beech 16 S 10 E 22 Elm 14 N 25 W 25  
1884 James Blair Found old stake & stones. Set iron, tile & brick.  
1986 Kenneth Suydam set a R.R. spike in the pavement at Blairs record distance from the north and by centering on the road fence.

B. Description of corner evidence found and/or method applied in restoring or reestablishing corner:

Aug 6-7 1997 I found R.R. spike and dug through the pavement but didn't find anything. I dug at two other spots but found nothing.  
Aug 27, 1997 I dug again after retracing Blairs 1884 survey and found field tile on end, pieces of vitrified tile & 3/4" X 9" iron bar 2 1/2' deep. Replaced the iron bar with 3/4" X 3' iron pipe capped G.E.R. 13040.  
Sept. 3, 1997 Set monument box in base course of asphalt over the 3/4" X 3' iron pipe

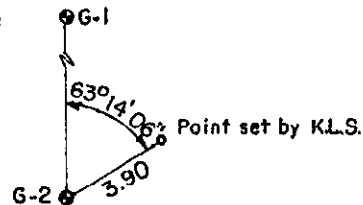

C. Description of monument for corner and accessories established to perpetuate locating the position of the corner:

3/4" X 3' iron pipe capped G.E.R. 13040 in monument box and is accepted as the best available evidence of the position of the original corner.  
dbl hd nail & disc in fence post West 20.26  
dbl hd nail & disc in fence post N 20° W 49.80  
SE corner of house foundation N 15° W 120.12  
Survey mark spike & re-mon tag in 12" Hickory S 85° E 59.61



Ratified by Peer Group in accordance with P.A. 345 Co. Rep. Glenn E. Richard Date Sept. 9, 1997

Signed by Glenn E. Richard Date Sept. 23, 1997  
Glenn E. Richard

Surveyor's Michigan License No. 13040