Filed under Remonumentation Act 345 of 1990

JAN 25 2000

LAND CORNER RECORDATION CERTIFICATE

Filing Requirement of Act 74, Mich. P.A. 1970

LIBER 1 PAGE 352

STATE OF MICHIGAN
LENAWEE COUNTY
FILED

15 NOV 1999 9:53:47 AM

VICTORIA J. DANIELS
REGISTER OF DEEDS

Register of Deeds Stamp & File Number

For corners in SECTION

Lenawee (County)

	Located In:	Corner Code #
1. Public Land Survey	T-9-S R-2-E	C-1
	T R	
	T R	
	T R	
2. Property Controlling	S T R	
in Section	S T R	
3. Miscellaneous	S T R	
Property in Sec	S T R	

4. Lot No. _____, Recorded Plat _____

5. Private Claims _____

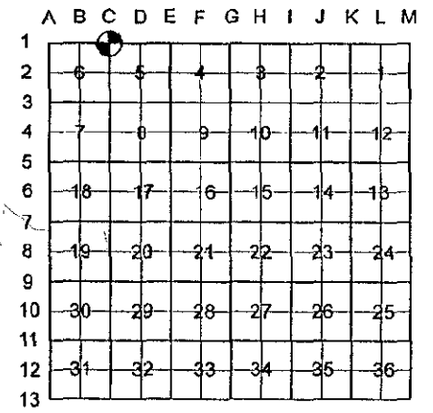

I, Glenn E. Richard, in a field survey on November 4, 19 99, do hereby certify that under requirements of P.A. 74, Michigan P.A. of 1970, the corner points mentioned in lines 1 and 2 above were in conformance with regulations and rules therefore as required in the current manual of survey instructions of the United States Department of the Interior, Bureau of Land Management or by a decree of a Court of Law and/or that the corner points mentioned in lines 3, 4 and 5 above were in conformance with the rules of the Michigan Board of Land Surveyors or by a Decree of a Court of Law; established, re-established, monumented, re-monumented, recovered, found as expressed below:

NOTE: Not more than 4 corners, all in the same town and range, may be recorded on this certificate.

A. Description of original monument and accessories and/or subsequent restoration:

GLO 1824 John Mullett intersect N. bdy 65 L (42.90') E. of post. Set post cor. Sec.'s 5 & 6 W. Oak 10 S 74 W 49 W. Oak 9 S 28 E 39
1873 James Blair did survey for Coomer St. and calls for the corner but not type of monumentation
1880± James Blair record of corner "Iron"
1883 James Blair used the corner for P.O.B. on the Plat of Frank Cowley's Addition No. 2 to Morenci
1936 Walter Frazier shows the corner on Assessor's Plat No. 2 of Morenci. Type of monumentation not given
1942 Walter Frazier shows the corner on field notes. Type of monumentation not given
1994 The City of Morenci installed a storm sewer thru this location

B. Description of corner evidence found and/or method applied in restoring or reestablishing corner:

1999 I retraced surveys & Plats along the town line to the east and surveys to the south on the west side of East St. which were all tied to the monumentation @ C-1 T9S R2E prior to being destroyed during storm sewer construction. November 4, 1999 Set 5/8" X 3' re-rod with Lenawee County Re-mon cap stamped P.S. 13040 and monument box at location approved by the Peer Group.

C. Description of monument for corner and accessories established to perpetuate locating the position of the corner:

5/8" X 3' re-rod with Lenawee County Re-mon cap stamped P.S. 13040 in monument box and is accepted as the best available evidence of the position of the original corner.

Plat monument N 50° W 54.47
Survey mark spike & Lenawee County Re-mon tag in T.P. N 50° W 39.30
Iron capped 30090 at back of curb N 40° E 32.45
dbl hd nail & Lenawee County re-mon tag in E.P. S 60° E 42.03

C-13 T8S R2E West 42.90

STATE OF MICHIGAN
GLENN E. RICHARD
No. 13040
PROFESSIONAL SURVEYOR

Ratified by Peer Group in accordance with P.A. 345 Co. Rep. Glenn E. Richard Date September 14, 1999

Signed by Glenn E. Richard Date Nov. 9, 1999
Glenn E. Richard

Surveyor's Michigan License No. 13040

FORM APPROVED BY MICHIGAN STATE BOARD OF LAND SURVEYORS, JAN. 28, 1971
REVISED MAY 14, 1975
REVISED JAN., 1983
ADAPTED FOR WORD PROCESSING MARCH, 1993