LAND CORNER RECORDATION CERTIFICATE
Filing Requirement of Act 74, Mich. P.A. 1970 as Amended

For corners in

Luce
(County)

	Located In:	Corner Code #
1. Public Land Survey	T 45N R 8W	K6
	T____ R____	
	T____ R____	
	S____ T____ R____	
2. Property Controlling	S____ T____ R____	
in Section	S____ T____ R____	
3. Miscellaneous	S____ T____ R____	
Property in Sec.	S____ T____ R____	

Register of Deeds Stamp & File Number

4. Lot No. _____ , Recorded Plat_____
5. Private Claims

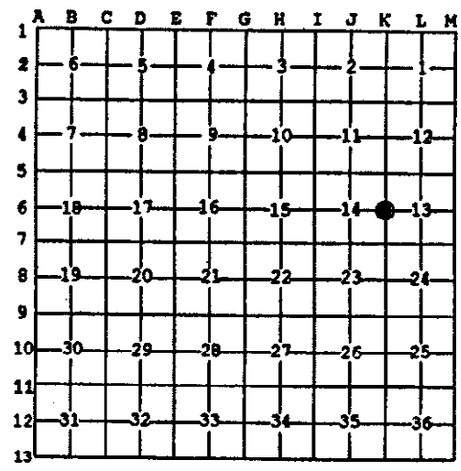

I, Stephan J. Szyszkoski, in a field survey on Jun 25 2003, 20 ____ do hereby state that under requirements of P.A. 74, Michigan P.A. of 1970, the corner points mentioned in lines 1 and 2 above were in conformance with regulations and rules therefore as required in the current manual of survey instructions of the United States Department of the Interior, Bureau of Land Management or by a decree of a Court of Law and /or that the corner points mentioned in lines 3, 4 and 5 above were in conformance with the rules of the Michigan Board of Land Surveyors or by a Decree of a Court of Law; established, re-established, monumented, recovered, found as expressed below:

NOTE: Not more than 2 corners, all in the same town and range, may be recorded on this certificate.

A. Description of original monument and accessories and/or subsequent restoration:

(K6) Quarter corner common to Sections 13-14. 1849: Established by Wm. Ives. N10'W between 13 & 14 ...32.80 W.Pine 30, 40.00 set qr Section post, Fir 7 S57E 10, Beech 8 N15W 23 ...80.00 Ironwood 10 for corner of sections. 1972: The corner was remonumented by Billy D. Buckler 475.2' north of the original W.Pine Line Tree [at 32.80] and a found wood post. Set 1" pipe with 4" aluminum cap. 14" Hemlock S83E 82.4', 10" Hemlock S43W 9.3' (ref. LCRC L1 P89 Luce County Records).

B. Description of corner evidence found and/or method applied in restoring or reestablishing corner:

(K6) Recovered the 1972 monument in good condition and at record bearing and distance from the 1972 witnesses, both in good condition with overgrown blazes. Left the monument in place and made new witnesses as described below.

C. Description of monument for corner and accessories established to perpetuate locating the position of the corner:

(K6) Found 1"ID I.pipe with 4" alum. MDNR cap. Blazed, scribed, and set measuring nails in:
18" Hemlock S78E 82.95' "1/4S" *
14" Hemlock S46W 9.6' do *
6" Balsam S39E 42.35' "1/4S NBT"
11" Maple S65W 30.3' do
Set a cedar post adjacent. Bearings are magnetic. Distances are to nail with tag.

STATE OF MICHIGAN
STEPHAN J. SZYSZKOSKI
LAND SURVEYOR
No. 33986
LICENSED LAND SURVEYOR

Signed by Stephan J. Szyszkoski Date 10/16/03

Surveyor's Michigan License No. 33986

For the Michigan Department of Natural Resources, Office of Land and Facilities

FORM APPROVED BY MICHIGAN STATE BOARD OF PROFESSIONAL SURVEYORS, JAN. 28, 1971
Revised May 14, 1975
Revised Jan., 1983
Revised Oct., 1995