

LAND CORNER RECORDATION CERTIFICATE
Filing Requirement of Act 74, Mich. P.A. 1970 as Amended

For corners in

<u>Luce</u> (County)	Located In:	Corner Code #
1. Public Land Survey	T <u>45N</u> R <u>8W</u>	<u>18</u>
	T _____ R _____	_____
	T _____ R _____	_____
2. Property Controlling in Section	S _____ T _____ R _____	_____
	S _____ T _____ R _____	_____
3. Miscellaneous Property in Sec.	S _____ T _____ R _____	_____
	S _____ T _____ R _____	_____

Register of Deeds Stamp & File Number

4. Lot No. _____, Recorded Plat _____
 5. Private Claims _____

Mar 17 2003

I, Stephan J. Szyszkoski, in a field survey on _____, 20____ do hereby state that under requirements of P.A. 74, Michigan P.A. of 1970, the corner points mentioned in lines 1 and 2 above were in conformance with regulations and rules therefore as required in the current manual of survey instructions of the United States Department of the Interior, Bureau of Land Management or by a decree of a Court of Law and /or that the corner points mentioned in lines 3, 4 and 5 above were in conformance with the rules of the Michigan Board of Land Surveyors or by a Decree of a Court of Law; established, re-established, monumented, recovered, found as expressed below:

	A	B	C	D	E	F	G	H	I	J	K	L	M
1													
2	6		5		4		3		2		1		
3													
4	7		8		9		10		11		12		
5													
6	18		17		16		15		14		13		
7													
8	19		20		21		22	●	23		24		
9													
10	30		29		28		27		26		25		
11													
12	31		32		33		34		35		36		
13													

NOTE: Not more than 2 corners, all in the same town and range, may be recorded on this certificate.

A. Description of original monument and accessories and/or subsequent restoration:


(18) Quarter corner common to Sections 22-23. 1849: Established by Wm. Ives Set qr. Section Post, Fir 10 S45W 14, Hemlock 14 N30E 17. 1972: Billy D. Buckler remonumented the corner from an original BT Hemlock N30E 17 links found with lower face and scribing visible. Set 1" iron pipe with 4" aluminum cap. 15" Soft Maple N80W 26.2', 22" Y.Birch S13W 22.9' (ref. LCRC L1 P91 Luce Co. Records). Found no subsequent record.

B. Description of corner evidence found and/or method applied in restoring or reestablishing corner:

(18) Found the 1972 monument in good condition and at record bearing and distance from the 1972 witnesses, both in good condition. The Y.Birch NBT is now 15" DBH suggesting a typographical error in 1972 record. Both NBTs blazes are now healed over. Left the monument in place and added new witnesses as described below.

C. Description of monument for corner and accessories established to perpetuate locating the position of the corner:

(18) Found 1" ID I.pipe with 4" alum. MDNR cap. Blazed, scribed, and set measuring nails in:
 15" Maple N78W 26.5' "1/4S" *
 15" Y.Birch S17W 23.5' do *
 16" Cedar S56E 46.40' "1/4S NBT"
 6" Maple N64E 13.75' do
 Bearings are magnetic. Distances are to nail with tag. * denotes 1972 NBT.

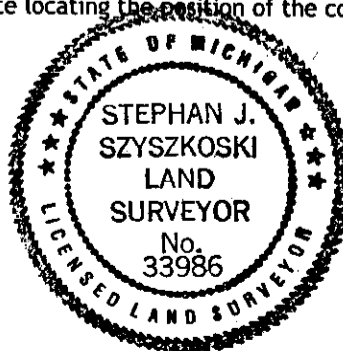

Signed by Stephan J. Szyszkoski
 Surveyor's Michigan License No. 33986

Date 10/16/03

For the Michigan Department of Natural Resources, Office of Land and Facilities