

LAND CORNER RECORDATION CERTIFICATE
Filing Requirement of Act 74, Mich. P.A. 1970 as Amended

For corners in

Luce	Located In:	Corner Code #
<small>(County)</small>		
1. Public Land Survey	T ___ R ___	_____
	T ___ R ___	_____
	T ___ R ___	_____
2. Property Controlling in Section	S ___ T ___ R ___	_____
	S 24 T 45N R 8W	14
	S 13 T 45N R 8W	4
3. Miscellaneous Property in Sec.	S ___ T ___ R ___	_____
	S ___ T ___ R ___	_____

Register of Deeds Stamp & File Number

4. Lot No. _____, Recorded Plat _____
 5. Private Claims

4 Jun 18 2003
 14 Jun 19 2003

I, Stephan J. Szyszkoski, in a field survey on _____, 20__ do hereby state that under requirements of P.A. 74, Michigan P.A. of 1970, the corner points mentioned in lines 1 and 2 above were in conformance with regulations and rules therefore as required in the current manual of survey instructions of the United States Department of the Interior, Bureau of Land Management or by a decree of a Court of Law and /or that the corner points mentioned in lines 3, 4 and 5 above were in conformance with the rules of the Michigan Board of Land Surveyors or by a Decree of a Court of Law; established, re-established, monumented, recovered, found as expressed below:

NOTE: Not more than 2 corners, all in the same town and range, may be recorded on this certificate.

1	A	B	C	D	E	F	G	H	I	J	K	L	M
2		6		5		4		3		2		1	
3													
4		7		8		9		10		11		12	
5													
6		18		17		16		15		14		13	
7													
8		19		20		21		22		23		24	
9													
10		30		29		28		27		26		25	
11													
12		31		32		33		34		35		36	
13													

A. Description of original monument and accessories and/or subsequent restoration:


- (14-Sec. 24) South 1/16 corner between Sections 24 T45N-R08W and 19 T45N-R07W. Not established in the original survey.
- (4-Sec. 13) Northwest 1/16 corner, Sec. 13. Not established in the original survey.

B. Description of corner evidence found and/or method applied in restoring or reestablishing corner:

- (14-Sec. 24) Established the corner midway and on a straight line between Quarter corner 1326.08' north and Section corner 1326.08' south.
- (4-Sec. 13) Established the corner at the intersection of straight lines connecting opposite 1/16 corners.

C. Description of monument for corner and accessories established to perpetuate locating the position of the corner:

(14) Set 1"IDx36" I.pipe with 4" alum. MDNR cap. Blazed, scribed, and set measuring nails in:	(4) Set 1"IDx36" I.pipe with 4" alum. MDNR cap. Blazed, scribed and set measuring nails in:
24" Maple N45E 1.15' "S1/16 8T"	4" Maple S08E 8.55' "NW1/16 8T"
5" Maple N37W 20.9' do	6" Maple N74W 10.8' do
8" Balsam S72W 7.1' do	12" Maple N10E 19.3' do
8" Balsam S20W 11.85' do	8" Maple S38W 15.9' do
Bearings are magnetic. Distances are to nail with tag.	Set cedar post adjacent. Bearings are magnetic. Distances are to nail with tag.

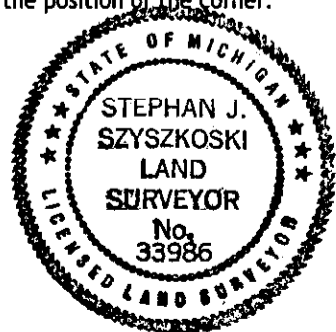

Signed by Stephan J. Szyszkoski
 Surveyor's Michigan License No. 33986

Date 10/16/03