LAND CORNER RECORDATION CERTIFICATE
Filing Requirement of Act 74, Mich. P.A. 1970 as Amended

For corners in

Luce (County)

	Located In:			Corner Code #
1. Public Land Survey		T___	R___	
		T___	R___	
		T___	R___	
	S___	T___	R___	
2. Property Controlling	S 14	T 45N	R 8W	7
in Section	S 24	T 45N	R 8W	11
3. Miscellaneous	S___	T___	R___	
Property in Sec.	S___	T___	R___	

Register of Deeds Stamp & File Number

4. Lot No. _____ , Recorded Plat_____

5. Private Claims

11 Jun 23 2003
7 Jun 18 2003

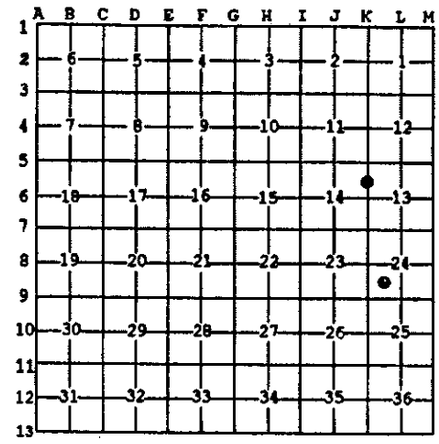

I, Stephan J. Szyszkoski, in a field survey on _____, 20 ____ do hereby state that under requirements of P.A. 74, Michigan P.A. of 1970, the corner points mentioned in lines 1 and 2 above were in conformance with regulations and rules therefore as required in the current manual of survey instructions of the United States Department of the Interior, Bureau of Land Management or by a decree of a Court of Law and /or that the corner points mentioned in lines 3, 4 and 5 above were in conformance with the rules of the Michigan Board of Land Surveyors or by a Decree of a Court of Law; established, re-established, monumented, recovered, found as expressed below:

NOTE: Not more than 2 corners, all in the same town and range, may be recorded on this certificate.

A. Description of original monument and accessories and/or subsequent restoration:

(7-Sec. 14) North 1/16 corner between Sections 13 & 14. Not established in the original survey.
(11-Sec. 24) Southwest 1/16 corner, Section 24. Not established in the original survey.

B. Description of corner evidence found and/or method applied in restoring or reestablishing corner:

(7-Sec. 14) Established the corner midway and on a straight line between Section corner 1333.07' north and Quarter corner 1333.07' south.
(11-Sec. 24) Established the corner at the intersection of straight lines connecting opposite 1/16 corners.

C. Description of monument for corner and accessories established to perpetuate locating the position of the corner:

(7) Set 1"IDx36" I.pipe with 4" alum. MDNR cap. Blazed, scribed, and set measuring nails in:

5" Maple N23W 24.9'	"N1/16 BT"
12" Maple N33E 26.9'	do
12" Maple S06E 7.8'	do
8" Maple S56W 37.6'	do

A squared post is West, 3.9'
Bearings are magnetic. Distances are to nail with tag.

(11) Set 1"IDx36" I.pipe with 4" alum. MDNR cap. Blazed, scribed, and set measuring nails in:

14" Hemlock S86W 19.5'	"SW1/16 BT"
10" Maple N58W 20.8'	do
6" Y.Birch N24E 7.35'	do
4" Maple S16W 17.25'	do

Set squared cedar post adjacent.
Bearings are magnetic. Distances are to nail with tag.

STATE OF MICHIGAN
STEPHAN J. SZYSZKOSKI
LAND SURVEYOR
No. 33986
LICENSED LAND SURVEYOR

Signed by Stephan J. Szyszkoski Date 10/16/03

Surveyor's Michigan License No. 33986

For the Michigan Department of Natural Resources, Office of Land and Facilities

FORM APPROVED BY MICHIGAN STATE BOARD OF PROFESSIONAL SURVEYORS, JAN. 28, 1971
Revised May 14, 1975
Revised Jan., 1983
Revised Oct., 1995