LAND CORNER RECORDATION CERTIFICATE
Filing Requirement of Act 74, Mich. P.A. 1970 as Amended

For corners in

Luce (County)

		Located In:		Corner Code #
1. Public Land Survey		T 45N	R 8W	K7
		T	R	
		T	R	
	S	T	R	
2. Property Controlling	S 24	T 45N	R 8W	12
in Section	S	T	R	
3. Miscellaneous	S	T	R	
Property in Sec.	S	T	R	

Register of Deeds Stamp & File Number

4. Lot No. _____ , Recorded Plat _____

5. Private Claims

12 Jun 19 2003
K7 Jun 25 2003

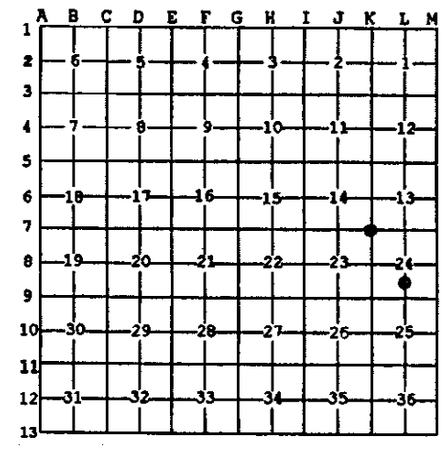

I, Stephan J. Szyszkoski, in a field survey on _____, 20 ____ do hereby state that under requirements of P.A. 74, Michigan P.A. of 1970, the corner points mentioned in lines 1 and 2 above were in conformance with regulations and rules therefore as required in the current manual of survey instructions of the United States Department of the Interior, Bureau of Land Management or by a decree of a Court of Law and /or that the corner points mentioned in lines 3, 4 and 5 above were in conformance with the rules of the Michigan Board of Land Surveyors or by a Decree of a Court of Law; established, re-established, monumented, recovered, found as expressed below:

NOTE: Not more than 2 corners, all in the same town and range, may be recorded on this certificate.

A. Description of original monument and accessories and/or subsequent restoration:

(K7) Corner common to Sections 13-14-23-24. 1972: Reestablished by single proportionate measurement by Billy D. Buckler. Set 1" iron pipe with 4" aluminum cap. 7" Soft Maple S43W 31.5', 12" Y.Birch N62W 38.4' (ref. LCRC L1 P87 Luce County Records).
(12-Sec. 24) South 1/16 corner, Section 24. Not established in the original survey.

B. Description of corner evidence found and/or method applied in restoring or reestablishing corner:

(K7) Recovered the 1972 monument in good condition and at record bearing and distance from the 1972 witness trees, both in good condition with overgrown blazes. Left the monument in place and made new witnesses as described below. The monument is located 5278.45' north of K9, 2641.91' south of K6, and is 21.7' west of a straight line between them.
(12-Sec. 24). Established the corner midway and on a straight line between Quarter corner 1325.97' south and Center of Section 1325.97' north.

C. Description of monument for corner and accessories established to perpetuate locating the position of the corner:

(K7) Found 1"ID I.pipe with 4" aluminum MDNR cap. Blazed, scribed, and set measuring nails in:
10" Maple S47W 31.25' "S23" *
16" Y.Birch S58W 38.9' "S14" *
8" Maple N33W 14.55' "S14 NBT"
10" Maple S82E 26.95' "S24 NBT"
Set a cedar post adjacent. Bearings are magnetic. Distances are to nail with tag. * denotes 1972 NBT.

(12) Set 1"IDx36" I.pipe with 4" alum. MDNR cap. Blazed, scribed, and set measuring nails in:
14" Maple S78W 11.85' "S1/16 BT"
6" Maple N20W 16.7' do
6" Spruce S77E 14.45' do
10" Spruce S14E 23.5' do
Set squared cedar post adjacent. Bearings are magnetic. Distances are to nail with tag.

STATE OF MICHIGAN
STEPHAN J. SZYSZKOSKI
LAND SURVEYOR
No. 33986
LICENSED LAND SURVEYOR

Signed by Stephan J Szyszkoski Date 10/16/03

Surveyor's Michigan License No. 33986

For the Michigan Department of Natural Resources, Office of Land and Facilities

FORM APPROVED BY MICHIGAN STATE BOARD OF PROFESSIONAL SURVEYORS, JAN. 28, 1971
Revised May 14, 1975
Revised Jan., 1983
Revised Oct., 1995