


LAND CORNER RECORDATION CERTIFICATE
Filing Requirement of Act 74, Mich. P.A. 1970

For corners in

Luce			
(County)	Located In:	Corner Code #	
1. Public Land Survey	T 45N R 8W	K11	
	T R		
	T R		
	T R		
2. Property Controlling in Section	S T R		
	S T R		
3. Miscellaneous Property in Sec.	S T R		
	S T R		

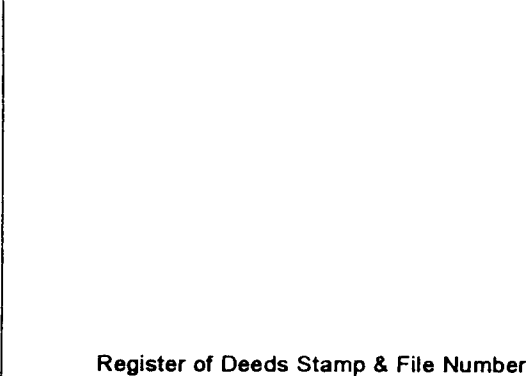

4. Lot No. _____, Recorded Plat _____
 5. Private Claims _____

May 10 2005

I, Stephan J. Szyszkoski, in a field survey on _____, 19____ do hereby state that under requirements of P.A. 74, Michigan P.A. of 1970, the corner points mentioned in lines 1 and 2 above were in conformance with regulations and rules therefore as required in the current manual of survey instructions of the United States Department of the Interior, Bureau of Land Management or by a decree of a Court of Law and /or that the corner points mentioned in lines 3, 4 and 5 above were in conformance with the rules of the Michigan Board of Land Surveyors or by a Decree of a Court of Law; established, re-established, monumented, recovered, found as expressed below:

NOTE: Not more than 2 corners, all in the same town and range, may be recorded on this certificate.

1	A	B	C	D	E	F	G	H	I	J	K	L	M
2		6		5		4		3		2		1	
3													
4		7		8		9		10		11		12	
5													
6		18		17		16		15		14		13	
7													
8		19		20		21		22		23		24	
9													
10		30		29		28		27		26		25	
11													
12		31		32		33		34		35		36	
13													


A. Description of original monument and accessories and/or subsequent restoration:
 (K11) Corner common to Sections 25-26-35-36. 1849: Established by Wm. Ives, Deputy Surveyor: "North between Sections 35&36 ... 80.00 Set post corner of Sections 25, 26, 35, 36. Hemlock 12 S35E 29, Hemlock 16 N40W 10". 1972: Reestablished by Billy D. Buckler RLS by single proportionate measurement between corners one mile to North and one mile to South. Found no evidence of original corner. Set 1" pipe with 4" aluminum cap. 10" Cedar N55E 34.4', 12" Hemlock S64E 33.4'.

B. Description of corner evidence found and/or method applied in restoring or reestablishing corner:

(K11) Found the 1972 monument in good condition and at record bearing and distance from the 1972 witnesses, both in good condition with overgrown blazes. Found the monument to be 1.68' East and 0.87' South of the single proportionate position described in the 1972 record. Accepted the monument as a careful and faithful reestablishment of the position of the original corner. Made new blazes on the 1972 witness trees.

C. Description of monument for corner and accessories established to perpetuate locating the position of the corner:

(K11) Found 1" ID I. pipe with 4" alum. MDNR cap. Set measuring nails in:
 12" Cedar N57E 34.52' mrkd "S25" *
 16" Hemlock S61E 33.85' mrkd "S36" *
 8" Cedar S35W 13.2' mrkd "S35 NBT"
 5" Hemlock N02E 4.45' "S25 NBT"
 Bearings are magnetic. Distances are to nail with tag. * denotes 1972 NBT.

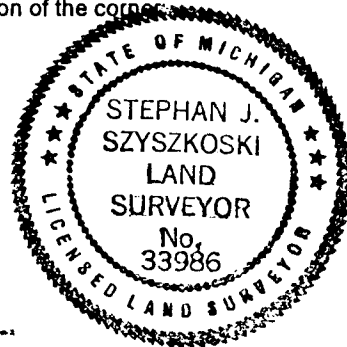

Signed by Stephan J. Szyszkoski
 Surveyor's Michigan License No. 33986

Date 6/21/05