

LAND CORNER RECORDATION CERTIFICATE
Filing Requirement of Act 74, Mich. P.A. 1970

For corners in

<u>Luce</u>	Located In:	Corner Code #	
<small>(County)</small>			
1. Public Land Survey	T <u>45N</u> R <u>8W</u>	<u>L11</u>	
	T <u> </u> R <u> </u>	<u> </u>	
	T <u> </u> R <u> </u>	<u> </u>	
	T <u> </u> R <u> </u>	<u> </u>	
2. Property Controlling in Section	S <u> </u> T <u> </u> R <u> </u>	<u> </u>	
	S <u> </u> T <u> </u> R <u> </u>	<u> </u>	
3. Miscellaneous Property in Sec.	S <u> </u> T <u> </u> R <u> </u>	<u> </u>	
	S <u> </u> T <u> </u> R <u> </u>	<u> </u>	

Register of Deeds Stamp & File Number

4. Lot No. _____, Recorded Plat _____
 5. Private Claims _____

May 09 2005

I, Stephan J. Szyszkoski, in a field survey on _____, 19____ do hereby state that under requirements of P.A. 74, Michigan P.A. of 1970, the corner points mentioned in lines 1 and 2 above were in conformance with regulations and rules therefore as required in the current manual of survey instructions of the United States Department of the Interior, Bureau of Land Management or by a decree of a Court of Law and /or that the corner points mentioned in lines 3, 4 and 5 above were in conformance with the rules of the Michigan Board of Land Surveyors or by a Decree of a Court of Law; established, re-established, monumented, recovered, found as expressed below:

NOTE: Not more than 2 corners, all in the same town and range, may be recorded on this certificate.

A	B	C	D	E	F	G	H	I	J	K	L	M
1												
2	6		5		4		3		2		1	
3												
4	7		8		9		10		11		12	
5												
6	18		17		16		15		14		13	
7												
8	19		20		21		22		23		24	
9												
10	30		29		28		27		26		25	
11												
12	31		32		33		34		35		36	
13												


A. Description of original monument and accessories and/or subsequent restoration:
 (L11) Quarter corner common to Sections 25-36. 1849: Established by Wm. Ives, Deputy Surveyor: "West established [between Sections 25 and 36] ...40.20 Set qr. Section post. Cedar 12 N47W 11, Fir 9 S64E 13 ...80.40 Corner". Found no subsequent record.

B. Description of corner evidence found and/or method applied in restoring or reestablishing corner:
 (L11) The original post and accessories were not recovered. Found no evidence of the position of the original corner on the ground. Reestablished the corner by single proportionate measurement to the original record between reestablished section corners 2644.08 feet east and west. The position for the corner falls 5 feet west of the center of a N-S trail.

C. Description of monument for corner and accessories established to perpetuate locating the position of the corner:

(L11) Set 1"IDx36" I.pipe with plastic cap stamped "MI DNR PS33986", set flush with the ground surface. Set measuring nails in:
 14" W.Pine N56W 11.2' mrd "1/4S NBT"
 5" Cedar S72W 11.3' do
 6" Spruce S53E 16.0' do
 8" Maple S75E 29.2' do

Bearings are magnetic. Distances are to nail with tag.

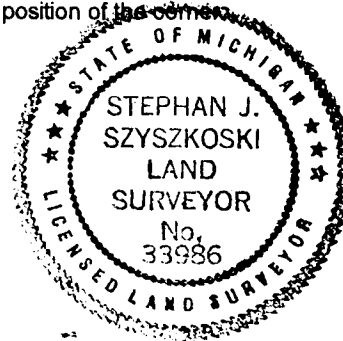

Signed by Stephan J. Szyszkoski
 Surveyor's Michigan License No. 33986

Date 6/21/05