


LAND CORNER RECORDATION CERTIFICATE
Filing Requirement of Act 74, Mich. P.A. 1970

For corners in

Luce	Located In:	Corner Code #
<small>(County)</small>		
1. Public Land Survey	T ___ R ___	_____
	T ___ R ___	_____
	T ___ R ___	_____
	T ___ R ___	_____
2. Property Controlling in Section	S <u>36</u> T <u>45N</u> R <u>8W</u>	<u>15</u>
	S ___ T ___ R ___	_____
3. Miscellaneous Property in Sec.	S ___ T ___ R ___	_____
	S ___ T ___ R ___	_____

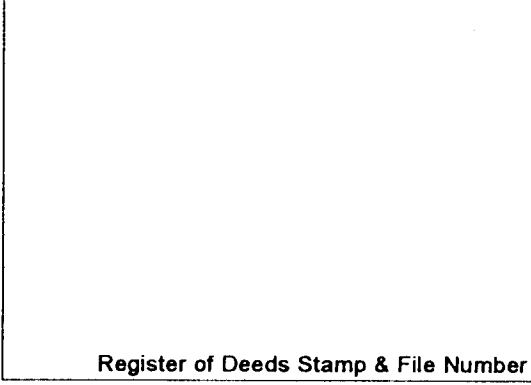

4. Lot No. _____, Recorded Plat _____
 5. Private Claims _____

May 10 2005

I, Stephan J. Szyszkoski, in a field survey on _____, 19____ do hereby state that under requirements of P.A. 74, Michigan P.A. of 1970, the corner points mentioned in lines 1 and 2 above were in conformance with regulations and rules therefore as required in the current manual of survey instructions of the United States Department of the Interior, Bureau of Land Management or by a decree of a Court of Law and /or that the corner points mentioned in lines 3, 4 and 5 above were in conformance with the rules of the Michigan Board of Land Surveyors or by a Decree of a Court of Law; established, re-established, monumented, recovered, found as expressed below:


NOTE: Not more than 2 corners, all in the same town and range, may be recorded on this certificate.

	A	B	C	D	E	F	G	H	I	J	K	L	M
1													
2		6		5		4		3		2		1	
3													
4		7		8		9		10		11		12	
5													
6		18		17		16		15		14		13	
7													
8		19		20		21		22		23		24	
9													
10		30		29		28		27		26		25	
11													
12		31		32		33		34		35		36	
13													

A. Description of original monument and accessories and/or subsequent restoration:
 (15-Sec. 36) West 1/16 corner between Section 36 T45N-R08W in Luce County and Section 1 T44N-R08W in Mackinac County. Not established in the original survey.

B. Description of corner evidence found and/or method applied in restoring or reestablishing corner:
 (15-Sec. 36) Established the corner on the township line between Section corner 1320.77' west and Quarter corner 1320.77' east.

C. Description of monument for corner and accessories established to perpetuate locating the position of the corner:
 (15) Set 1"IDx36" I.pipe with 4" alum. MDNR cap. Set measuring nails in:
 5" Balsam S28W 2.65' mrd "W1/16 BT"
 6" Balsam N71W 9.81' do
 6" Maple East 29.6' do
 5" Maple S52E 8.93' do
 Set cedar post adjacent. Bearings are magnetic. Distances are to nail with tag.

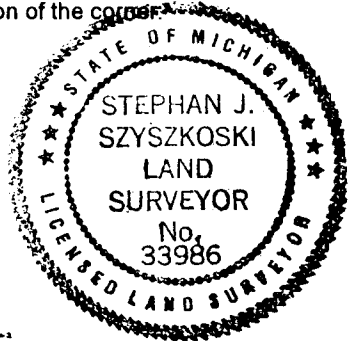

Signed by Stephan J. Szyszkoski
 Surveyor's Michigan License No. 33986

Date 6/21/05