

MICHIGAN
DEPARTMENT OF CONSERVATION
FORESTRY DIVISION

LAND CORNER RECORD

T. 44,45N N.R. 9W


Luce & Mackinac COUNTY

DESCRIPTION OF CORNER Sec. Cor. common to Secs. 5-6-31-32

CORNER MONUMENT 1" pipe with 4" aluminum cap

DATE MONUMENT PLACED AND WITNESSED 4-29-69

WITNESSES TO CORNER..... 6" W. Pine (S31 NBT) N54°W 6.0'

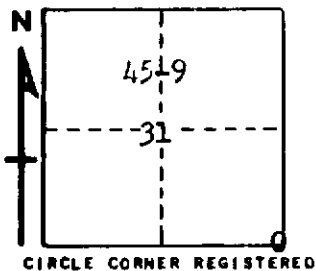

7" W. Pine (S32 NBT) N22°E 42.5'

AND

DESCRIPTION IN DETAIL AS TO HOW CORNER WAS LOCATED AND IDENTIFIED OR RESTORED.

This corner re-established midway between $\frac{1}{4}$ corners; $\frac{1}{2}$ mile east and $\frac{1}{2}$ mile west and in an E-W fence line. Found no evidence of original corner.

SURVEYOR'S SEAL

SIGNED *Billy D. Buckler*
Billy D. Buckler DATE 8-28-69
REGISTERED LAND SURVEYOR