

# LAND CORNER RECORDATION CERTIFICATE

## FILING REQUIREMENT OF ACT 74, MICH. P.A.1970

Luce Co.

Three Corners.

FOR CORNERS OF--	LOCATED IN--	CORNER CODE NUMBER
1. PUBLIC LAND SURVEY _____	T. <u>45</u> <sup>N.</sup> <del>S.</del> , R. <u>9</u> <sup>E.</sup> <del>W.</del>	F-7 F-9
2. PROPERTY CONTROLLING IN SECTION <u>20</u>	T. <u>45</u> <sup>N.</sup> <del>S.</del> , R. <u>9</u> <sup>E.</sup> <del>W.</del>	16, Sec. 20
3. MISCELLANEOUS PROPERTY IN SECTION _____	T. _____ <sup>N.</sup> <del>S.</del> , R. _____ <sup>E.</sup> <del>W.</del>	_____
4. LOT NO. _____, RECORDED PLAT _____		
5. PRIVATE CLAIMS _____		

REGISTER OF DEEDS STAMP AND  
FILING NUMBER

I, Billy D. Buckler do hereby certify that under requirements of P.A. 74, Michigan P.A. of 1970, the corner points mentioned in lines 1 and 2 above (identified with circles on index code diagram - over) were, in a field survey on 9-25 & 10-8 1974, established, re-established, monumented, re-monumented, recovered or restored as expressed below and in conformance with regulations and rules therefore as required in the current manual of survey instructions of the United States Department of the Interior, Bureau of Land Management or by a decree of a court of law. Furthermore, that the corner points mentioned in lines 3, 4 and 5 above were, in a field survey on \_\_\_\_\_ 19\_\_\_\_, found, recovered, restored, established or re-established as expressed below and in conformance with the rules of the Michigan State Board of Registration for Land Surveyors or, by a Decree of a Court of law:

**A. Description of original monument and accessories and/or subsequent restoration:**

Corners set by Williams Ives, D.S. in 1849.

F-7  $\frac{1}{4}$  Cor. bet. Secs. 16-21. Bearings were: Beech 6, N18°W, 31 lks & Sugar 8, S62°E, 30 lks.

F-9  $\frac{1}{4}$  Cor. bet. Secs. 21-28. Bearings were: Hemlock 10, S60°W, 12 lks & Fir 6, N65°E, 32 lks.

16-Sec.20 East 1/16 Corner on South side, Section 20

**B. Description of corner evidence found and/or method applied in restoring or re-establishing corner:**

F-7 Monumented  $\frac{1}{4}$  Corner at an old fence Corner. Position agrees with other corners in area. Found no original evidence at this corner.

F-9 Corner re-established midway and on line bet. two Sec. Cors. Found no evidence of original corner.

16-Sec.20 Corner placed midway bet.  $\frac{1}{4}$  Corner to West and Section Corner to East.

**C. Description of monument for corner and accessories established to perpetuate locating the position of the corner:**

Placed 1" pipe with 4" aluminium cap at all corners.

F-7 New Bearings: 8" R. Pine, N22°W, 24.0' and 10" B. Cherry, S86°W, 15.0'


F-9 New bearings: 16" W. Pine, S25°E, 9.0' and 12" Cedar, N32°E, 16.8'

16-Sec.20 Bearings: 10" B. Cherry, S85°W, 3.9' and 24" Soft Maple, S4°W, 51.4'

SIGNED BY Billy D. Buckler  
Billy D. Buckler

DATE 10-30-74

SURVEYOR'S MICHIGAN REGISTRATION NO. 8887

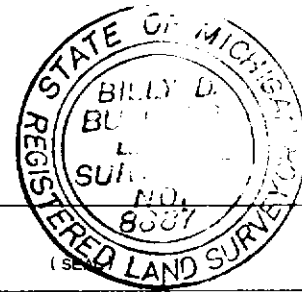

FOR STATE AND UNITED STATES AGENCIES:

SIGNED BY \_\_\_\_\_ DATE \_\_\_\_\_  
CHIEF OF SURVEY PARTY

APPROVED AND SIGNED BY \_\_\_\_\_ DATE \_\_\_\_\_  
MICHIGAN REGISTERED LAND SURVEYOR

(SEAL)

SURVEYOR'S MICHIGAN REGISTRATION NO. \_\_\_\_\_