

1993

LUCE COUNTY REMONUMENTATION CORNER

COMMISSION

LAND CORNER RECORDATION CERTIFICATE
Filing Requirement of Act 74, Mich. P.A. 1970

For corners in Luce

(County)	Located In:	Corner Code #
1. Public Land Survey	T 45N R 9W	B-3
	T _____ R _____	_____
	T _____ R _____	_____
	T _____ R _____	_____
2. Property Controlling in Section	S _____ T _____ R _____	_____
	S _____ T _____ R _____	_____
3. Miscellaneous Property in Sec.	S _____ T _____ R _____	_____
	S _____ T _____ R _____	_____
4. Lot No. _____, Recorded Plat _____		
5. Private Claims _____		

Filed 12-22 A.D., 1993

At 10:00 o'clock A.M.

File No. 91 480

Keith R. Waters
Luce County Reg. of Deeds

Register of Deeds Stamp & File Number

Keith R. Waters September 93

I, _____, in a field survey on _____, 19_____, do hereby certify that under requirements of P.A. 74, Michigan P.A. of 1970, the corner points mentioned in lines 1 and 2 above were in conformance with regulations and rules therefore as required in the current manual of survey instructions of the United States Department of the Interior, Bureau of Land Management or by a decree of a Court of Law and/or that the corner points mentioned in lines 3, 4 and 5 above were in conformance with the rules of the Michigan Board of Land Surveyors or by a Decree of a Court of Law; established, re-established, monumented, re-monumented, recovered, found as expressed below:

NOTE: Not more than 4 corners, all in the same town and range, may be recorded on this certificate.

A	B	C	D	E	F	G	H	I	J	K	L	M
2	6	5	4	3	2	1						
3	•											
4	7	8	9	10	11	12						
5												
6	18	17	16	15	14	13						
7												
8	19	20	21	22	23	24						
9												
10	30	29	28	27	26	25						
11												
12	31	32	33	34	35	36						
13												

A. Description of original monument and accessories and/or subsequent restoration:
B-3 1/4 Corner Common to Sections 6 & 7, T45N, R9W

Original ties to post: 1979 - The north line of Section 7 is shown on a survey recorded by Thomas A. Beaudrie, R.L.S. 11359, in Book 1, Page 20, Luce County recorded surveys. No location is shown for the 1/4 corner.


B. Description of corner evidence found and/or method applied in restoring or reestablishing corner:

B-3
This corner is being re-established as part of the Luce County Remonumentation Program. Found no evidence of corner. Distance between Section corners east and west is within 1.45 feet of original G.L.O. distance. Re-established corner by single proportionate measurement between Section corners east and west. Found a capped "T" iron, Eino Sainio, L.S. 7873, 330.00 feet east, and 32.64 feet north of set 1/4 corner, on the north right-of-way line of County Road 457. Corner measures 2639.27 feet to Section corner east and 2604.96 feet to section corner west.

C. Description of monument for corner and accessories established to perpetuate locating the position of the corner:
B-3
Corner is a 1/2" rebar with 3 1/4" aluminum Luce County cap 2.2 feet north of centerline of County Road 457. Witnesses:

- 8" Sugar Maple, N48°W 83.08'
- Power Pole (ML2-5-10), N39°W 45.49'
- 5" Sugar Maple, N18°E 52.38'
- 4" Beech, S10°E 54.00'

Note: Distances are to a nail and tag in the side of witness object. Trees are blazed and painted. Bearings are compass bearings corrected for declination.

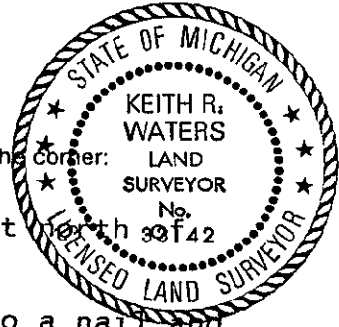

Signed by Keith R. Waters Date 12-20-93
Surveyor's Michigan License No. 33142