

1993

LUCE COUNTY REMONUMENTATION CORNER

COMMISSION

LAND CORNER RECORDATION CERTIFICATE
Filing Requirement of Act 74, Mich. P.A. 1970

For corners in Luce

(County)	Located In:	Corner Code #
1. Public Land Survey	T <u>45N</u> R <u>9W</u>	<u>C-3</u>
	T _____ R _____	_____
	T _____ R _____	_____
	T _____ R _____	_____
2. Property Controlling in Section	S _____ T _____ R _____	_____
	S _____ T _____ R _____	_____
3. Miscellaneous Property in Sec.	S _____ T _____ R _____	_____
	S _____ T _____ R _____	_____
4. Lot No. _____, Recorded Plat _____		
5. Private Claims _____		

Filed 12-22 A.D.; 19 93

At 10:00 o'clock A.M.

File No. 93 479

Keith R. Waters
Luce County Reg. of Deeds

Register of Deeds Stamp & File Number

I, Keith R. Waters, in a field survey on September, 19 93

do hereby certify that under requirements of P.A. 74, Michigan P.A. of 1970, the corner points mentioned in lines 1 and 2 above were in conformance with regulations and rules therefore as required in the current manual of survey instructions of the United States Department of the Interior, Bureau of Land Management or by a decree of a Court of Law and/or that the corner points mentioned in lines 3, 4 and 5 above were in conformance with the rules of the Michigan Board of Land Surveyors or by a Decree of a Court of Law; established, re-established, monumented, re-monumented, recovered, found as expressed below:


NOTE: Not more than 4 corners, all in the same town and range, may be recorded on this certificate.

	A	B	C	D	E	F	G	H	I	J	K	L	M
2	6		5	4	3	2	1						
3			●										
4	7	8	9	10	11	12							
5													
6	18	17	16	15	14	13							
7													
8	19	20	21	22	23	24							
9													
10	30	29	28	27	26	25							
11													
12	31	32	33	34	35	36							
13													

A. Description of original monument and accessories and/or subsequent restoration:

C-3 Corner Common to Sections 5,6,7, & 8, T45N, R9W

Original ties to post:	1979 - This corner is shown on survey recorded by
Sugar 10, N57°W 35 links	Thomas A. Beaudrie, R.L.S. 11359, in Book 1 Page
Sugar 12, S50°E 16 links	20, of Luce County recorded surveys as <u>Section 5</u>
	corner iron in center of road.

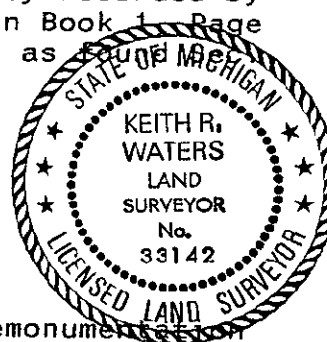

B. Description of corner evidence found and/or method applied in restoring or reestablishing corner:

C-3

This corner is being perpetuated as part of the Luce County Remonumentation Program. Found a 1/2" iron in approximate centerline of east-west gravel road (County Road 411) on line with a fence to the north. Distance to Section corner 1 mile west fits well with that shown on Beaudrie survey. Distance west to centerline of County road 457 also fits with Beaudrie survey. Accepted corner position as found and set a 3 1/4" aluminum Luce County cap on iron.

C. Description of monument for corner and accessories established to perpetuate locating the position of the corner:

C-3

Corner is a 1/2" rebar with 3 1/4" aluminum Luce County cap in the centerline of County Road 457 at a fence line to the north. Witnesses:

- Power Pole (583), N11°E 39.38'
- 12" Sugar Maple, N20°E 103.12'
- 20" Sugar Maple, S80°E 106.08'
- 16" White Pine, S68°W 79.10'

Note: Distances are to a nail and tag in the side of witness object. Trees are blazed and painted. Bearings are compass bearings corrected for declination.

Signed by Keith R. Waters

Date 12-20-93

Surveyor's Michigan License No. 33142