

SURVEY & REMONUMENTATION

LUCE COUNTY REMONUMENTATION CORNER

APR 28 1995

LAND CORNER RECORDATION CERTIFICATE

Filing Requirement of Act 74, Mich. P.A. 1970

For corners in **COMMISSION**

(County) _____ Located In: _____ Corner Code # _____


1. Public Land Survey T 45N R 9W C-4
 T _____ R _____
 T _____ R _____
 T _____ R _____

2. Property Controlling S _____ T _____
 in Section S _____ T _____

3. Miscellaneous S _____ T _____
 Property in Sec. S _____ T _____

4. Lot No. _____, Recorded Plat _____

5. Private Claims _____

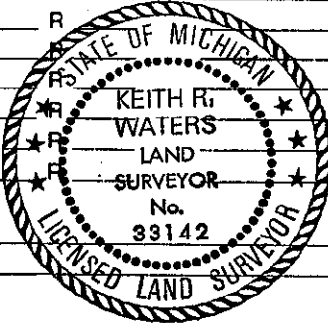

Filed 1/20 A.D., 19 95
 At 12:30 o'clock P. M.
 Liber 2
 File No. page 610
Keith R. Waters
 Luce County Reg. of Deeds

Register of Deeds Stamp & File Number

Keith R. Waters December 7 19 94

I, _____ in a field survey on _____, 19 _____ do hereby certify that under requirements of P.A. 74, Michigan P.A. of 1970, the corner points mentioned in lines 1 and 2 above were in conformance with regulations and rules therefore as required in the current manual of survey instructions of the United States Department of the Interior, Bureau of Land Management or by a decree of a Court of Law and/or that the corner points mentioned in lines 3, 4 and 5 above were in conformance with the rules of the Michigan Board of Land Surveyors or by a Decree of a Court of Law; established, re-established, monumented, re-monumented, recovered, found as expressed below:

NOTE: Not more than 4 corners, all in the same town and range, may be recorded on this certificate.

A. Description of original monument and accessories and/or subsequent restoration:


C-4 1/4 Corner Common to Sections 7 & 8, T45N, R9W

Original ties to post: Beech 7, S75°W 21 links Sugar 14, N80°E 14 links.
 1979 - Corner is shown on a survey recorded on page 20, Luce County Certified Surveys, by Thomas Beaudrie, RLS 11359. Found 1/4 corner fence and timber corner. Distance to section corner north is shown as 2667.5 feet.

B. Description of corner evidence found and/or method applied in restoring or reestablishing corner:

C-4 (T45N, R9W)

This corner is being perpetuated as part of the Luce County Remonumentation Program. Found remains of a wood post on line with an old fence to the west, approximately 2 feet west of a new north-south fence line. Post is 2661.67 from section corner to the north, 2631.33 feet from section corner to the south, and is 0.43 feet east of a straight line between said section corners. Set a 1/2" rebar in the centerline of wood post remains.

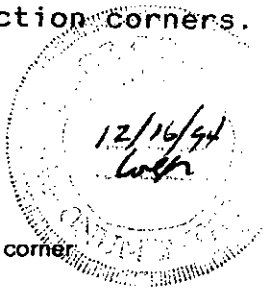

C. Description of monument for corner and accessories established to perpetuate locating the position of the corner:

C-4 (T45N, R9W)

Corner is a 1/2" rebar with plastic cap #33142 on the extension of an old fence line to the west, 2 feet west of a new north-south fence line. Witnesses:

- 14" Red Pine, S83°E 15.94'
- 12" Norway Spruce, N28°E 19.54'
- 10" Norway Spruce, S19°E 12.70'
- 12" Red Pine, S74°W 42.38'

Note: Distances are to a nail and tag in the side of the tree. Trees are blazed and painted. Bearings are compass bearings corrected for declination.

Signed by Keith R. Waters Date 12-23-94

Surveyor's Michigan License No. 33142