

SURVEY & REMONUMENTATION

LUCE COUNTY REMONUMENTATION CORNER

APR 28 1995

LAND CORNER RECORDATION CERTIFICATE

Filing Requirement of Act 74, Mich. P.A. 1970

COMMISSION

For corners in Luce

Located In: _____ Corner Code # _____

(County) _____


1. Public Land Survey T 45N R 9W D-9
 T _____ R _____
 T _____ R _____
 T _____ R _____

2. Property Controlling in Section S _____ T _____ R _____
 S _____ T _____ R _____

3. Miscellaneous Property In Sec. S _____ T _____ R _____
 S _____ T _____ R _____

4. Lot No. _____, Recorded Plat _____

5. Private Claims _____

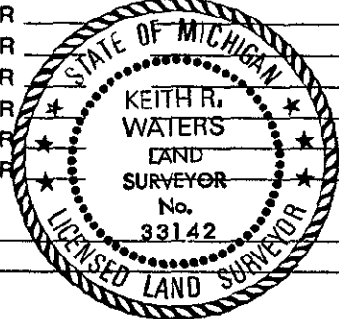

Filed 1/20 A.D., 19 95
 At 12:30 o'clock P. M.
 Liber 2
 File No. page 613
Kathy S. Nolan
 Luce County Reg. of Deeds
 Register of Deeds Stamp & File Number

	A	B	C	D	E	F	G	H	I	J	K	L	M
2	6	5	4	3	2	1							
3													
4	7	8	9	10	11	12							
5													
6	18	17	16	15	14	13							
7													
8	19	20	21	22	23	24							
9													
10	30	29	28	27	26	25							
11													
12	31	32	33	34	35	36							
13													

I, Keith R. Waters in a field survey on September 20, 19 94, do hereby certify that under requirements of P.A. 74, Michigan P.A. of 1970, the corner points mentioned in lines 1 and 2 above were in conformance with regulations and rules therefore as required in the current manual of survey instructions of the United States Department of the Interior, Bureau of Land Management or by a decree of a Court of Law and/or that the corner points mentioned in lines 3, 4 and 5 above were in conformance with the rules of the Michigan Board of Land Surveyors or by a Decree of a Court of Law; established, re-established, monumented, re-monumented, recovered, found as expressed below:

NOTE: Not more than 4 corners, all in the same town and range, may be recorded on this certificate.

A. Description of original monument and accessories and/or subsequent restoration:
D-9 1/4 Corner Common to Sections 20 & 29, T45N, R9W

Original ties to post: Fir 12, N73°E 23 links
 Sugar 6, 45°W 21 links
 1974 - Billy Buckler, RLS 8887, as recorded on page 181, Luce County corner records. Buried 1" x 30" iron in west half of north-south road
 Witnesses: 6" Red Pine, N30°W 55.6'
 4" Red Pine, S75°W 36.8'



B. Description of corner evidence found and/or method applied in restoring or reestablishing corner:
D-9 (T45N, R9W)

This corner is being perpetuated as part of the Luce County Remonumentation Program. Found a 1" i.d. iron pipe 6.5 feet west of the centerline of a north-south gravel road, 1 foot south of the south end of asphalt pavement on County Road 399. Also found both bearing trees as called for in 1974 records. Accepted corner as found and established additional witness objects.

C. Description of monument for corner and accessories established to perpetuate locating the position of the corner:
D-9 (T45N, R9W)

Corner is a 1" i.d. iron pipe 6.5 feet west of the centerline of County Road 399, 1 foot south of the south end of asphalt pavement. Witnesses:
 14" Red Pine, S75°W 37.08'
 7" Red Pine, N60°W 47.97'
 12" Red Pine, N30°W 55.92'
 Power Pole (ML2-52-30)
 N28°E 124.92'

Note: Distances are to a nail and tag in the side of the witness object. Trees are blazed and painted. Bearings are compass bearings corrected for declination.

Signed by Keith R. Waters Date 12-23-94
 Surveyor's Michigan License No. 33142