

SURVEY & REMONUMENTATION

APR 28 1995


LUCE COUNTY REMONUMENTATION CORNER

COMMISSION

LAND CORNER RECORDATION CERTIFICATE
Filing Requirement of Act 74, Mich. P.A. 1970

For corners in Luce

(County)	Located In:	Corner Code #
1. Public Land Survey	T 45N R 9W	E-3
	T _____ R _____	
	T _____ R _____	
	T _____ R _____	
2. Property Controlling in Section	S _____ T _____	
	S _____ T _____	
3. Miscellaneous Property in Sec.	S _____ T _____	
	S _____ T _____	
4. Lot No. _____, Recorded Plat _____		
5. Private Claims _____		

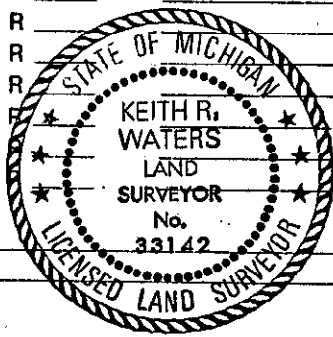

Filed 1/20 A.D., 19 95
At 12:30 o'clock P.M.
Liber 2
File No. page 615
Kathy S. Mahan
Luce County Reg. of Deeds
Register of Deeds Stamp & File Number

A	B	C	D	E	F	G	H	I	J	K	L	M
2	6		5		4		3		2		1	
3				●								
4	7		8		9		10		11		12	
5												
6	18		17		16		15		14		13	
7												
8	19		20		21		22		23		24	
9												
10	30		29		28		27		26		25	
11												
12	31		32		33		34		35		36	
13												

Keith R. Waters in a field survey on December 7, 19 94
do hereby certify that under requirements of P.A. 74, Michigan P.A. of 1970, the corner points mentioned in lines 1 and 2 above were in conformance with regulations and rules therefore as required in the current manual of survey instructions of the United States Department of the Interior, Bureau of Land Management or by a decree of a Court of Law and/or that the corner points mentioned in lines 3, 4 and 5 above were in conformance with the rules of the Michigan Board of Land Surveyors or by a Decree of a Court of Law, established, re-established, monumented, re-monumented, recovered, found as expressed below:


NOTE: Not more than 4 corners, all in the same town and range, may be recorded on this certificate.

A. Description of original monument and accessories and/or subsequent restoration:
E-3 Corner Common to Sections 4, 5, 8, & 9, T45N, R9W

Original ties to post: Beech 12, S59°W 54 links Beech 10, N60°E 44 links.
1963 - Billy Buckler, RLS 8887, as recorded on page 578A, Luce County corner records. Set 1" pipe with 4" cap at intersection of roads east, west south. Witness: 10" Hard Maple, N20°W 51 links.

B. Description of corner evidence found and/or method applied in restoring or reestablishing corner:
E-3 (T45N, R9W)

This corner is being perpetuated as part of the Luce County Remonumentation Program. Found a 1" pipe with 4" DNR cap on the north edge of east-west gravel road, at the intersection of gravel road to the south. Also found bearing tree as called for in 1963 records. Accepted corner as found and established new bearing trees.

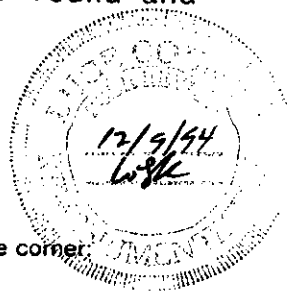

C. Description of monument for corner and accessories established to perpetuate locating the position of the corner:
E-3 (T45N, R9W)
Corner is a 1" pipe with 4" DNR cap on the north edge of an east-west gravel road, at intersection of gravel road to south. Witnesses:

- 10" Red Pine, S35°E 62.60'
- 8" Red Pine, S34°W 82.70'
- 12" Sugar Maple, N50°W 49.12'
- 24" Sugar Maple, N13°W 34.17'

Note: Distances are to a nail and tag in the side of the witness object. Trees are blazed and painted. Bearings are compass bearings corrected for declination.

Signed by Keith R. Waters Date 12-23-94
Surveyor's Michigan License No. 33142