

COMMISSION

LAND CORNER RECORDATION CERTIFICATE

Filing Requirement of Act 74, Mich. P.A. 1970

For corners in Luce

(County)	Located In:	Corner Code #
	45N 9W	E-5
1. Public Land Survey	T ___ R ___	_____
	T ___ R ___	_____
	T ___ R ___	_____
	T ___ R ___	_____
2. Property Controlling in Section	S ___ T ___ R ___	_____
	S ___ T ___ R ___	_____
3. Miscellaneous Property in Sec.	S ___ T ___ R ___	_____
	S ___ T ___ R ___	_____
4. Lot No. _____, Recorded Plat _____		
5. Private Claims _____		

Filed 12-22 A.D., 1993

At 10:00 o'clock A. M.

File No. 49 423

Keith R. Waters
Luce County Reg. of Deeds

Register of Deeds Stamp & File Number

I, Keith R. Waters, in a field survey on October, 1993,

do hereby certify that under requirements of P.A. 74, Michigan P.A. of 1970, the corner points mentioned in lines 1 and 2 above were in conformance with regulations and rules therefore as required in the current manual of survey instructions of the United States Department of the Interior, Bureau of Land Management or by a decree of a Court of Law and/or that the corner points mentioned in lines 3, 4 and 5 above were in conformance with the rules of the Michigan Board of Land Surveyors or by a Decree of a Court of Law; established, re-established, monumented, re-monumented, recovered, found as expressed below:

NOTE: Not more than 4 corners, all in the same town and range, may be recorded on this certificate.

A. Description of original monument and accessories and/or subsequent restoration:

E-5 Corner Common to Sections 8,9,16, & 17, T45N, R9W

Original ties to post:
Sugar 14, S45°W 13 links
Sugar 9, N38°E 45 links

B. Description of corner evidence found and/or method applied in restoring or reestablishing corner:

E-5

This corner is being re-established as part of the Luce County Remonumentation Program. Found no evidence of corner. In talking with Eino Sainio, P.S. 7873, he indicated that he had established corner location several years ago based on some very old highway plans and had set a wood post 75 feet south of corner on the south side of Highway M-28. Re-established corner 75 feet north of found wood post with Sainio tag. East-west position checks well with several north-south fence lines on small parcels to the west on the south side of Highway M-28. Distance to recorded section corner 1 mile north is within 0.66 feet of original GLO distance.


C. Description of monument for corner and accessories established to perpetuate locating the position of the corner:

E-5

Corner is a $\frac{1}{2}$ " rebar with $3\frac{1}{4}$ " aluminum Luce County cap 0.5 feet north of centerline of Highway M-28 at centerline of County Road 411 to the north.
Witnesses:

- 12" Red Pine, N24°W 92.12'
- 14" Red Pine, N17°E 89.98'
- 5" Red Pine, N61°E 93.67'
- 7" White Pine, S09°E 57.41'

Note: Distances are to a nail and tag in side of tree. Trees are blazed and painted. Bearings are compass bearings corrected for declination.

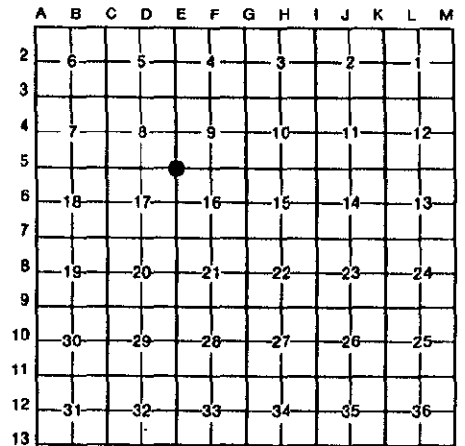

Signed by Keith R. Waters

Date 12-20-93

Surveyor's Michigan License No. 33142