

SURVEY & REMONUMENTATION

LUCE COUNTY REMONUMENTATION CORNER

APR 28 1995

LAND CORNER RECORDATION CERTIFICATE

Filing Requirement of Act 74, Mich. P.A. 1970

For corners in **COMMISSION**
Luce

Located In: _____ Corner Code # _____

(County) _____


1. Public Land Survey T 45N R 9W E-9
 T _____ R _____
 T _____ R _____
 T _____ R _____

2. Property Controlling S _____ T _____
 in Section S _____ T _____

3. Miscellaneous S _____ T _____
 Property in Sec. S _____ T _____

4. Lot No. _____, Recorded Plat _____

5. Private Claims _____

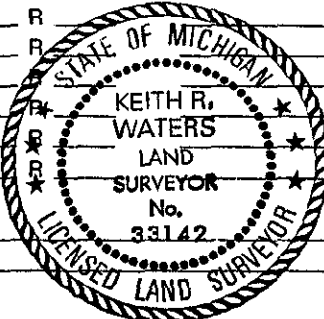

Filed 1/20 A.D., 19 95
 At 12:30 o'clock P.M.
 Liber 2
 File No. page 618
Kathy S. Mahan
 Luce County Reg. of Deeds

Register of Deeds Stamp & File Number

	A	B	C	D	E	F	G	H	I	J	K	L	M
2	6	5	4	3	2	1							
3													
4	7	8	9	10	11	12							
5													
6	18	17	16	15	14	13							
7													
8	19	20	21	22	23	24							
9													
10	30	29	28	27	26	25							
11													
12	31	32	33	34	35	36							
13													

I, Keith R. Waters in a field survey on December 1, 1994
 do hereby certify that under requirements of P.A. 74, Michigan P.A. of 1970, the corner points mentioned in lines 1 and 2 above were in conformance with regulations and rules therefore as required in the current manual of survey instructions of the United States Department of the Interior, Bureau of Land Management or by a decree of a Court of Law and/or that the corner points mentioned in lines 3, 4 and 5 above were in conformance with the rules of the Michigan Board of Land Surveyors or by a Decree of a Court of Law; established, re-established, monumented, re-monumented, recovered, found as expressed below:

NOTE: Not more than 4 corners, all in the same town and range, may be recorded on this certificate.


A. Description of original monument and accessories and/or subsequent restoration:
E-9 Corner Common to Sections 20, 21, 28, & 29, T45N, R9W

Original ties to post: Fir 8, S62°W 28 links
 Spruce 8, N44°E 25 links

1969 - As recorded by Billy Buckler, RLS 8887, Luce County corner records. Corner placed at location of several old squared stakes. Corner lies 15 feet south of intersection of roads north, east, and west. Witnesses:
 6" B. Cherry, S32°E 31.4' 6" B. Cherry, S51°W 12.9'

B. Description of corner evidence found and/or method applied in restoring or reestablishing corner:
E-9 (T45N, R9W)

This corner is being perpetuated as part of the Luce County Remonumentation Program. Found a 1" iron pipe with a 4" DNR cap and two bearing trees as called for in 1969 records. Accepted corner as found and established additional bearing trees.

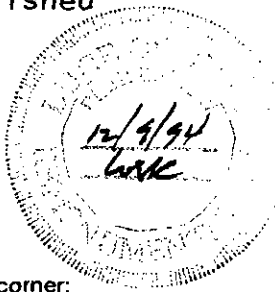

C. Description of monument for corner and accessories established to perpetuate locating the position of the corner:
E-9 (T45N, R9W)

Corner is a 1" pipe with 4" DNR cap approximately 15 feet south of intersection of 2-track roads north, east, and west. Witnesses:

5" Red Maple, NORTH 4.36'
 7" Cherry, N51°W 13.08'
 7" Red Maple, EAST 18.86'
 6" Cherry, S32°E 31.65'

Note: Distances are to a nail and tag in the side of the tree. Trees are blazed and painted. Bearings are compass bearings corrected for declination.

Signed by Keith R. Waters Date 12-23-94
 Surveyor's Michigan License No. 33142