

**SURVEY & REMONUMENTATION**

**LUCE COUNTY REMONUMENTATION CORNER**

APR 28 1995

**LAND CORNER RECORDATION CERTIFICATE**

Filing Requirement of Act 74, Mich. P.A. 1970

**COMMISSION**

For corners in Luce

(County)

Located In:

Corner Code #

1. Public Land Survey

T 45N R 9W

F-7

2. Property Controlling in Section


S T R

3. Miscellaneous Property in Sec.

S T R

4. Lot No. , Recorded Plat

5. Private Claims

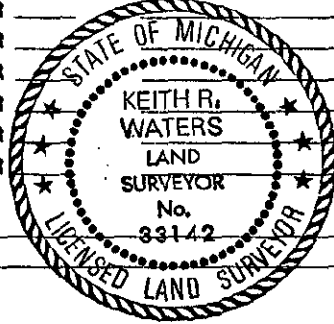

Filed 1/20 AD., 1995

At 12:30 o'clock P. M.

Liber 2

File No. page 616

*Keith R. Waters*  
Luce County Reg. of Deeds

Register of Deeds Stamp & File Number

	A	B	C	D	E	F	G	H	I	J	K	L	M
2	6	5	4	3	2	1							
3													
4	7	8	9	10	11	12							
5													
6	18	17	16	15	14	13							
7													
8	19	20	21	22	23	24							
9													
10	30	29	28	27	26	25							
11													
12	31	32	33	34	35	36							
13													

I, Keith R. Waters in a field survey on October 5, 1994

do hereby certify that under requirements of P.A. 74, Michigan P.A. of 1970, the corner points mentioned in lines 1 and 2 above were in conformance with regulations and rules therefore as required in the current manual of survey instructions of the United States Department of the Interior, Bureau of Land Management or by a decree of a Court of Law and/or that the corner points mentioned in lines 3, 4 and 5 above were in conformance with the rules of the Michigan Board of Land Surveyors or by a Decree of a Court of Law; established, re-established, monumented, re-monumented, recovered, found as expressed below:

**NOTE: Not more than 4 corners, all in the same town and range, may be recorded on this certificate.**

A. Description of original monument and accessories and/or subsequent restoration:


F-7 1/4 Corner Common to Sections 16 & 21, T45N, R9W

Original ties to post: Beech 6, N18°W 31 links Sugar 8, S62°E 30 links.  
1974 - Billy Buckler, RLS 8887, as recorded on page 182, Luce County corner records. Corner monumented at an old fence corner. Witnesses:  
8" Red Pine, N22°W 24.0' 10" B. Cherry, S86°W 15.0'

B. Description of corner evidence found and/or method applied in restoring or reestablishing corner:

F-7 (T45N, R9W)

This corner is being perpetuated as part of the Luce County Remonumentation Program. Found a 1" pipe with DNR cap on the north side of an east-west 2-track road, approximately 50 feet east of a north-south 2-track road. Also found stump of red pine bearing tree as called for in 1975 records. Accepted corner as found and established new bearing trees.

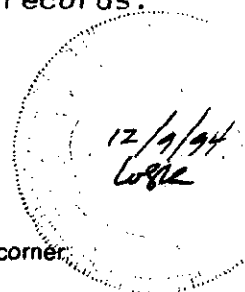

C. Description of monument for corner and accessories established to perpetuate locating the position of the corner:

F-7 (T45N, R9W)

Corner is a 1" iron pipe with a 4" DNR cap 17 feet north of east-west 2-track road, 50 feet east of a north-south 2-track road. Witnesses:

- 7" Balsam Fir, S02°E 38.50'
- 14" Red Pine, N69°W 35.28'
- 9" Red Pine, N44°W 24.36'
- 12" Red Pine, N14°W 13.90'

Note: Distances are to a nail and tag in the side of the tree. Trees are blazed and painted. Bearings are compass bearings corrected for declination.

Signed by Keith R. Waters

Date 12-23-94

Surveyor's Michigan License No. 33142